WATER SERVICE RECORD

Name

Service No.

Address *64 Farmcrest Avenue*

Location

Repair—Renewal—New Service

Date	Material	Amount	Total	Date			Amount
						OUTSIDE	
				1985	*1'*	*1" Copper*	
						1" Corp	
						3/4" x 1" Reducer	
					26.5'	*3/4" Copper*	
						3/4" Curb Stop	
						Box & Rod	

DATE _____

TOWN OF LEXINGTON — BOARD OF PUBLIC WORKS

WATER DIVISION

Sketch of Service Here

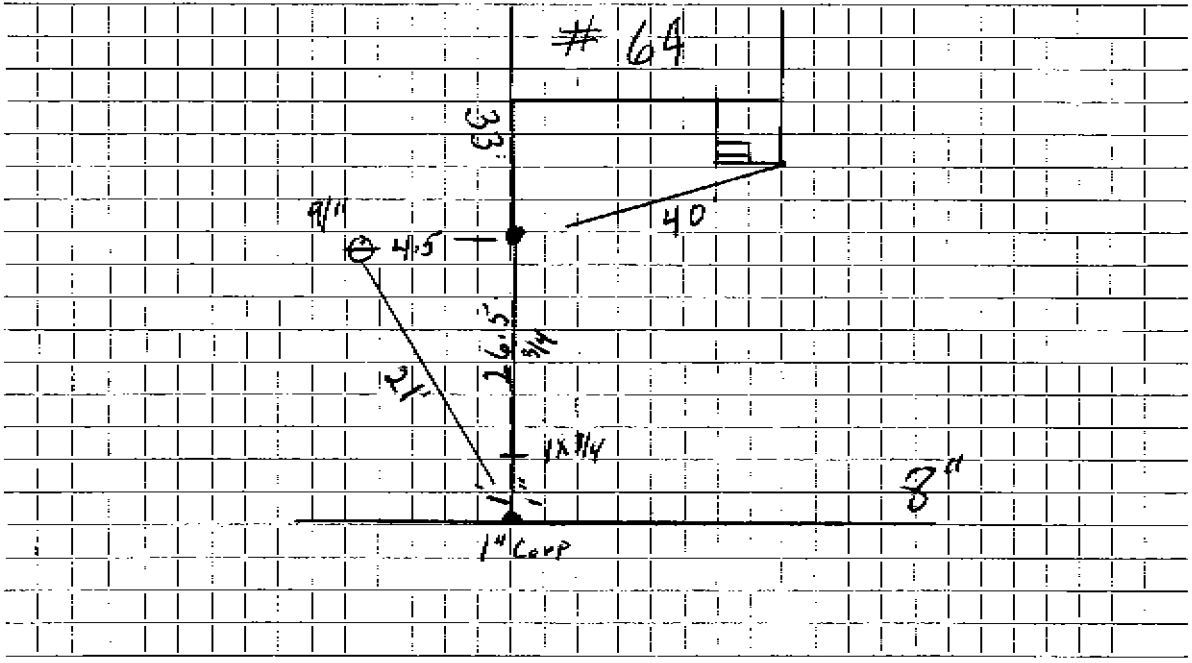

Connection made in ..... Street. Work completed .....

Remarks: .....

.....

.....