WATER SERVICE RECORD

Name | **Service No.**

Address 5 Fessenden Way

Location Map 53 Lot 45

Repair—Renewal—New Service

Date		Material	Amount	Total	Date		Deflice	Amount
9/9/60	72'	3/4 Copper			5/31/07	11.5	1" Copper	
	1	3/4 3part Union					1" Corp	
	1	3/4 x 1/2 Sleeve				6.5'	1" Curb Stop	
							1" x 3/4 Union	
							buffalo box	

DATE _____

TOWN OF LEXINGTON — BOARD OF PUBLIC WORKS

WATER DIVISION

Sketch of Service Here

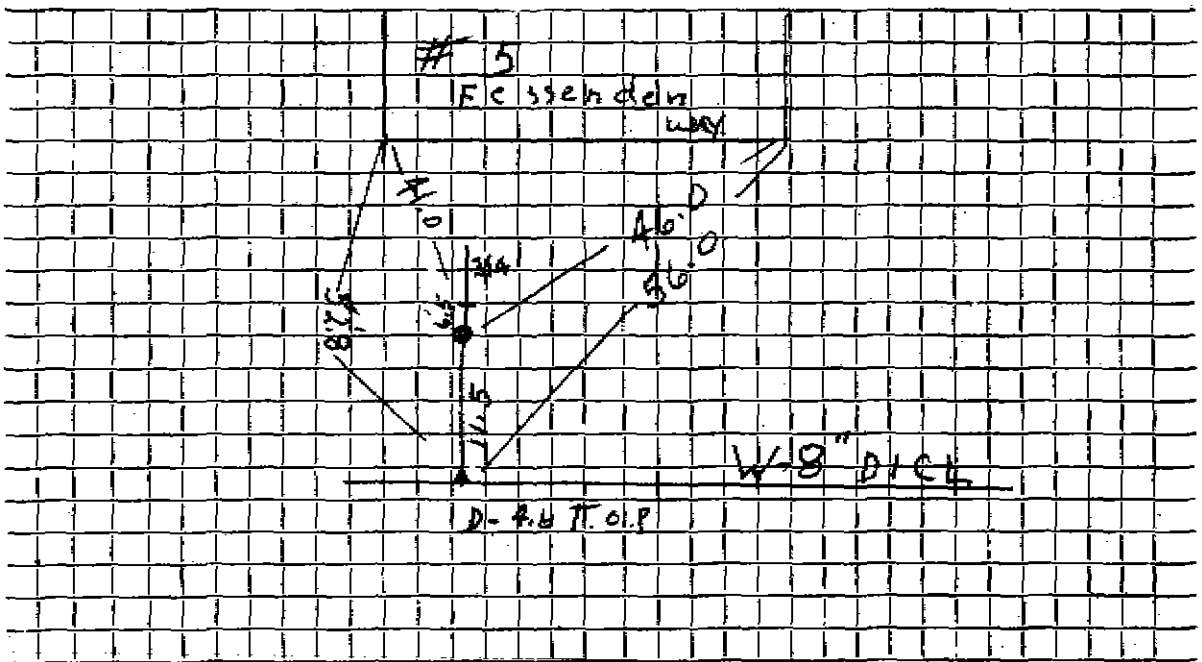

Connection made in ..... Street. Work completed 5/31/07 Deflick

Remarks: .....

.....

.....