WATER SERVICE RECORD

Name **Service No.**

Address 6 Fessenden Way

Location MAP 53 LOT 50

Repair—Renewal—New Service

Date		Material	Amount	Total	Date		Deflice	Amount
9/2/60	70'	3/4 Copper			5/31/07	22'	1" Copper	
	1	3/4" 3 part Union					1" Corp	
		3/4 x 1/2 Saw					1" Curb Stop	
							1" x 3/4 Union	
							buffalo box	

DATE _____

TOWN OF LEXINGTON — BOARD OF PUBLIC WORKS

WATER DIVISION

Sketch of Service Here

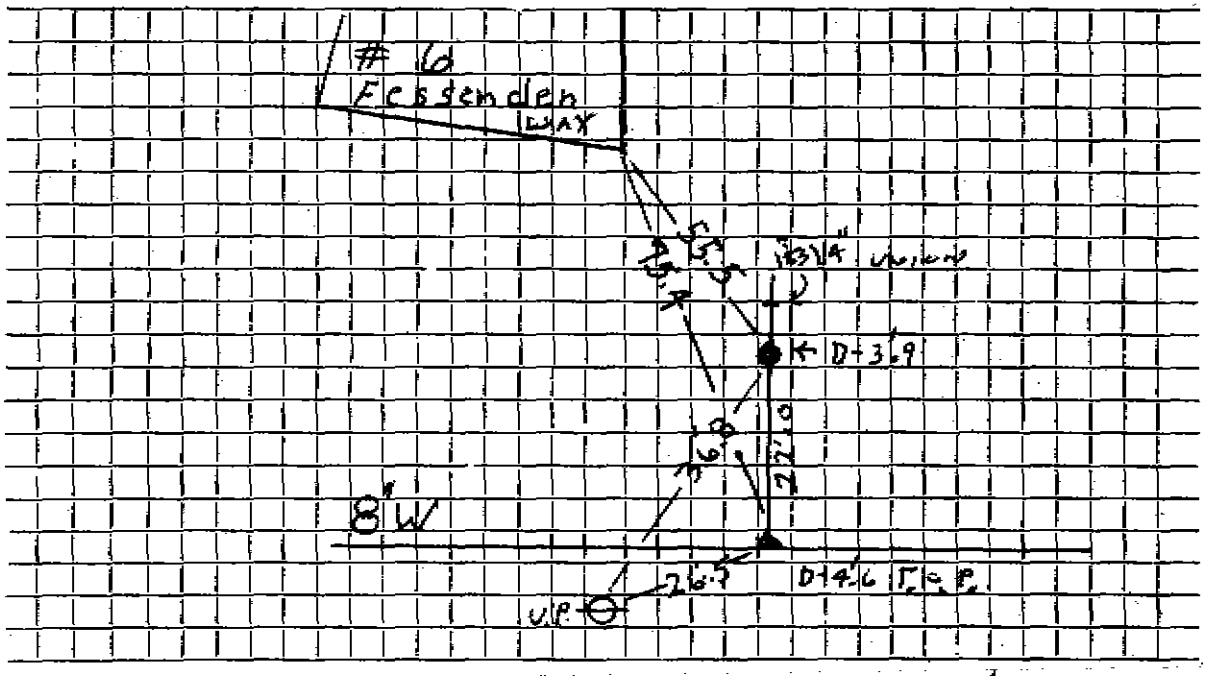

Connection made in ..... Street. Work completed 5/31/07 DeFelice

Remarks: New 8" W. Main 2007 D.I.C.L. Pipe