WATER SERVICE RECORD

Name | **Service No.**

Address 9 Fessenden Way

Location Map 53 Lot 43

Repair—Renewal—New Service

Date		Material	Amount		Total		Date			Amount	
9/26/60	50'	3/4 Copper					5/30/07	13.0	1" copper		
		3/4 x 1/2 S & W							1" Corp		
									1" Curb Stop		
									1" x 3/4 Union		
									buffalo box		

DATE _____

TOWN OF LEXINGTON — BOARD OF PUBLIC WORKS

WATER DIVISION

Sketch of Service Here

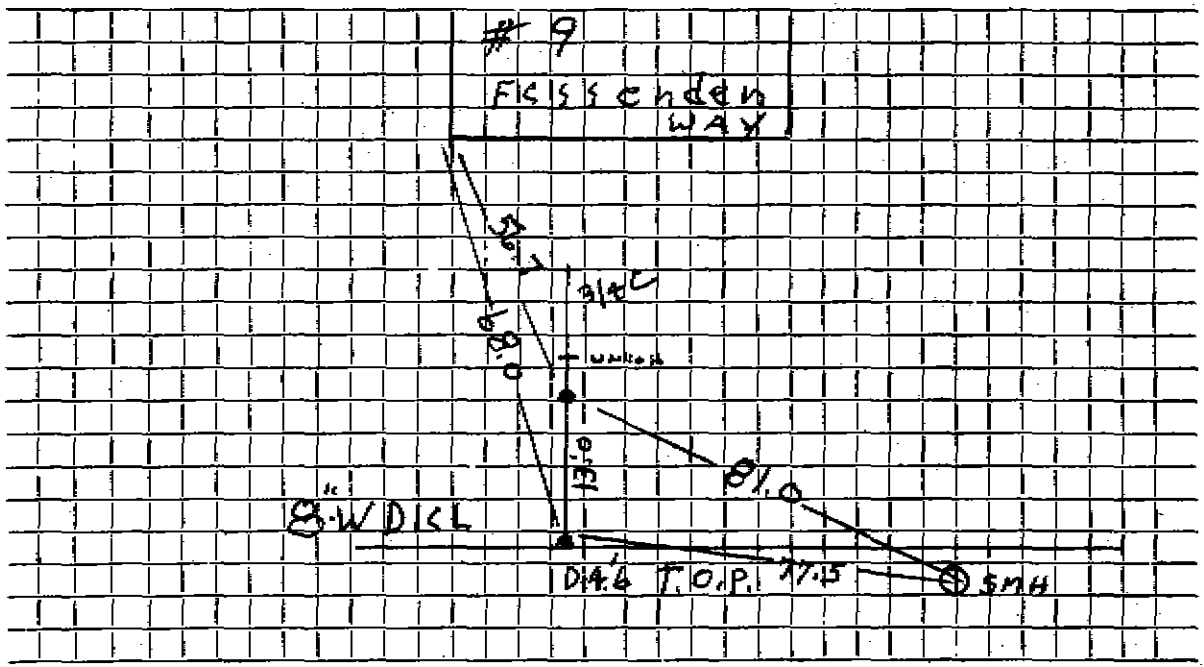

Connection made in ..... Street. Work completed 5/30/07 Deflice

Remarks: .....