Name Site & Shelter, Inc. - Joseph A. Zaffina

Service No. ~~299~~ 69

Address 10 Field Road

#3651

Lexington, Mass. Location

Kind of Pipe Suburbanite Cesspool Permit ~~Size~~ #394

Size of Main

~~Repair~~ Renewal—New Service

Com. 12-0-51

Location

SEP 27 1965

Date	Material	Amount	Total	Date		Amount
8-24-65	52' 3/4" copper tubing			7-20-65	Deposit	21 43
					NON CHARGE	
				10/30/51	Labor	3 67
					9' -3/4" copper tubing @ .326	2 93
					1 - 3/4" C. corp-cock	4 33
					1 - 3/4" C x 3/4" C. curb-cock	4 67
					1 box end rod	4 68
					1 hr. trucking	75
						21 03
	Labor					

The Bailey Press, Boston

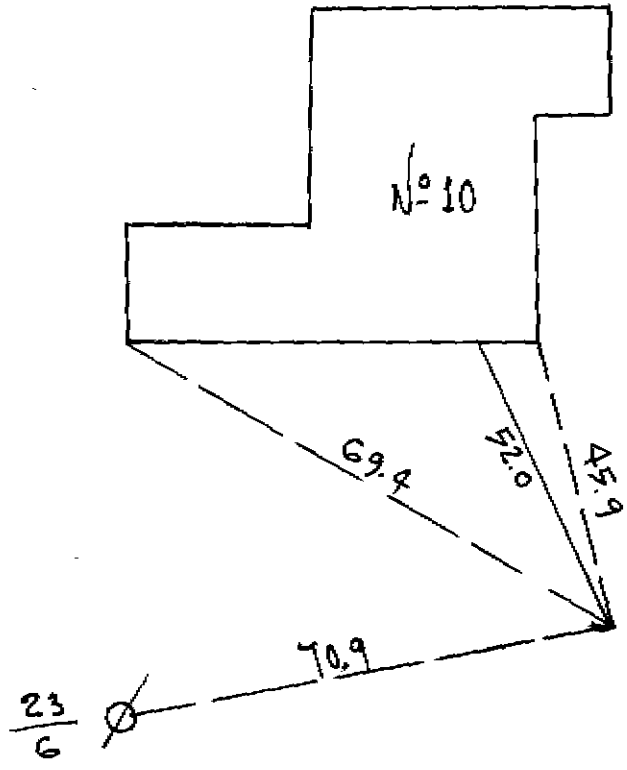
№ 10
69,4
52,0
45,9
70,9
23
6