WATER SERVICE RECORD

Name

Service No.

Address 20 FLINTLOCK RD

Location " "

Repair—Renewal—New Service McLAUGHLIN

Date		Material	Amount	Total	Date		Amount
7/17/98	52'	1" COPPER					
		1" CURB STOP			8/30/54	10' 3/4 COPPER	
	1	3/4 x 1" UNION				3/4 CORP	
		BUFFLO BOX					

DATE _____

TOWN OF LEXINGTON — BOARD OF PUBLIC WORKS

WATER DIVISION

Sketch of Service Here

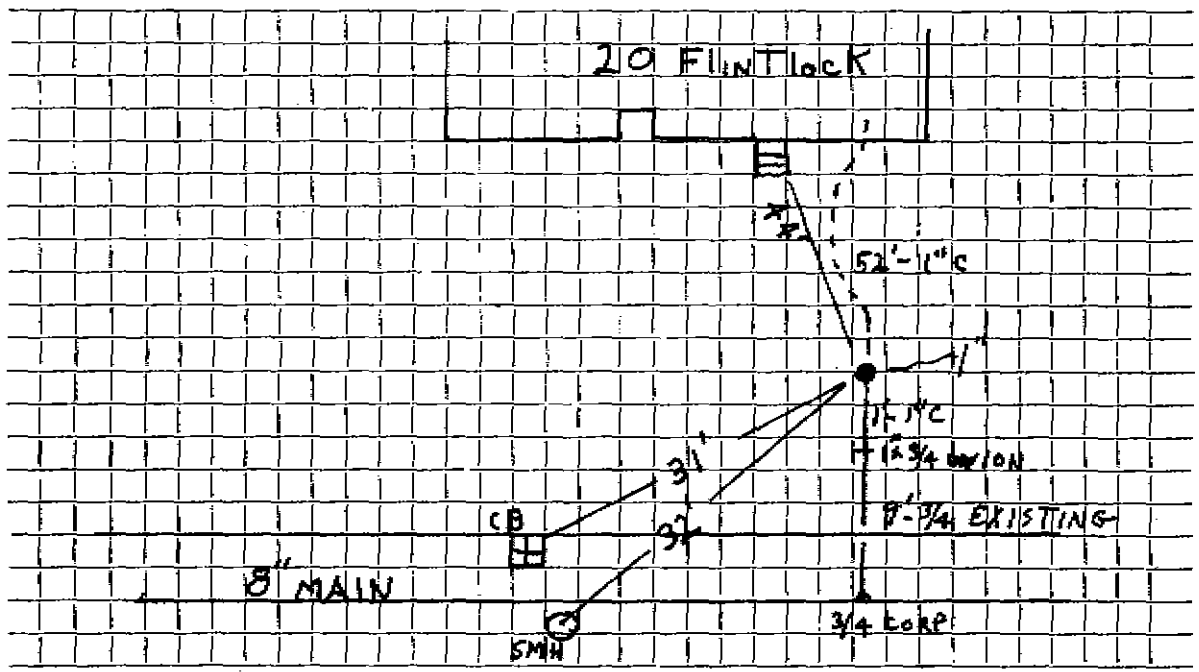

Connection made in ..... Street. Work completed .....

Remarks: .....

.....

.....