WATER SERVICE RECORD

Name

Service No.

Address 7 FLINT LOOP

McLAUGHLIN

Location

Repair—Renewal—New Service

Date		Material	Amount		Total		Date			Amount	
6/20/18		1" TYPE K COPPER									
		1" CURB STOP									
		CAM. DRAIN (12)									

DATE 6/2014

TOWN OF LEXINGTON — BOARD OF PUBLIC WORKS

WATER DIVISION

Sketch of Service Here

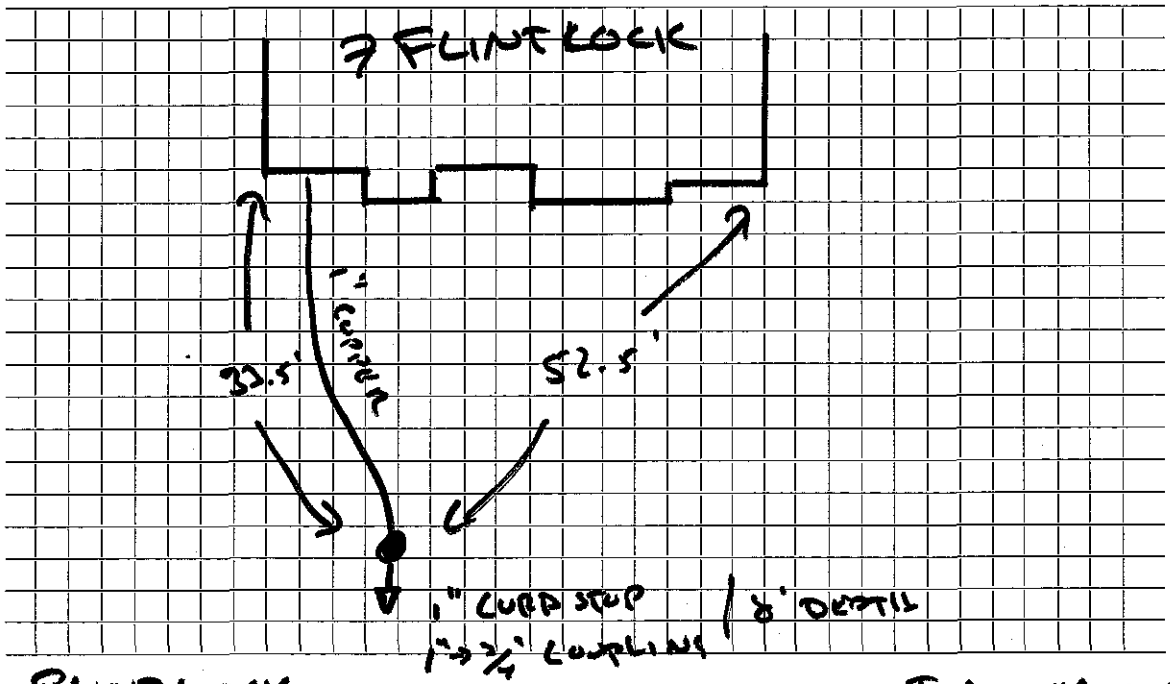

Connection made in FLINT LOCK Street. Work completed JIM MCLAUGHLIN

Remarks: