WATER SERVICE RECORD

Name

Service No.

Address 77 Follen RD

Location

Repair—Renewal—New Service DAVE SANTO

Date		Material	Amount	Total	Date	OUT TOWN INST.	Amount
9-96	43'5"	3/4 COPPER			9/12/96	18' 3/4 COPPER	
		3/4 VALVE				5/8 X 3/4 CORP ADPT	
						1- 3/4 MULLER UNION	
						3/4 CURB STOP	
						13 ox w Rod	

DATE_____

TOWN OF LEXINGTON — BOARD OF PUBLIC WORKS

WATER DIVISION

Sketch of Service Here

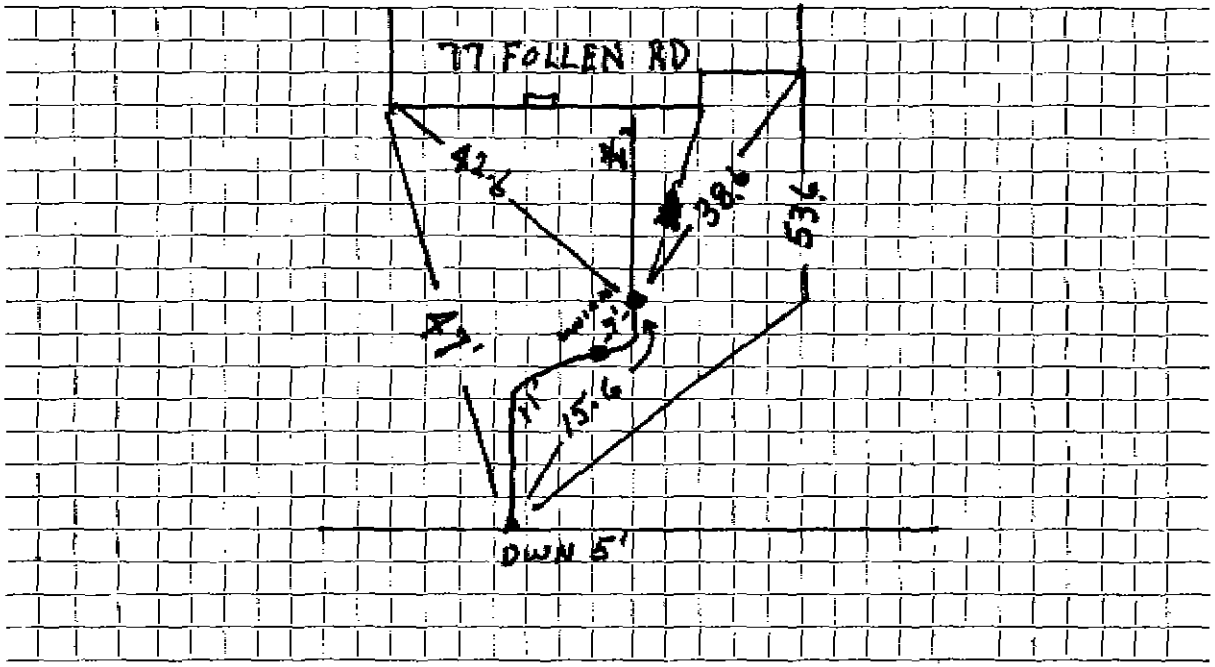

Connection made in FOLLEN RD ..... Street. Work completed 9/12/96 .....

Remarks: 15'6" TO COPP STRIGHT LINE .....

..... TOWN CONNECTED TO COPPER CONT INS TO 7' FROM CURB .....

.....