H.B.M.16010

#1838

WATER SERVICE RECORD

Name William Hamilton **Service No.** 25

Address 12 Freemont Street

Location

~~Repair~~—~~Renewal~~—**New Service** Comm 7-5-60

Date		Material	Amount	Total		Date			Amount	
4-28-60		Labor 2.05				4-4-60		Deposit	50	00
		10 % O.H. .21		2	26	7-1-60	*	Refund	22	36
	40'	3/4" Copper tubing @ .42		16	80				27	64
	1	3/4" C x ½ I.W.H. Stop & Waste		6	17					
	1	3/4" C 3 Part Union		2	41			NON CHARGE		
				27	64			Labor	1	61
							30'	3/4" Copper tubing @.42	12	60
							1	3/4" C Curb Cock	6	28
							1	3/4" C Corp Cock	4	91
							1	Box & Rod	5	00
							1	½ Straight tailpiece		50
							1	½ Offset tailpiece		50
									31	40

* Applied to Sheet #24

DATE _____

TOWN OF LEXINGTON — BOARD OF PUBLIC WORKS

WATER DIVISION

Sketch of Service Here

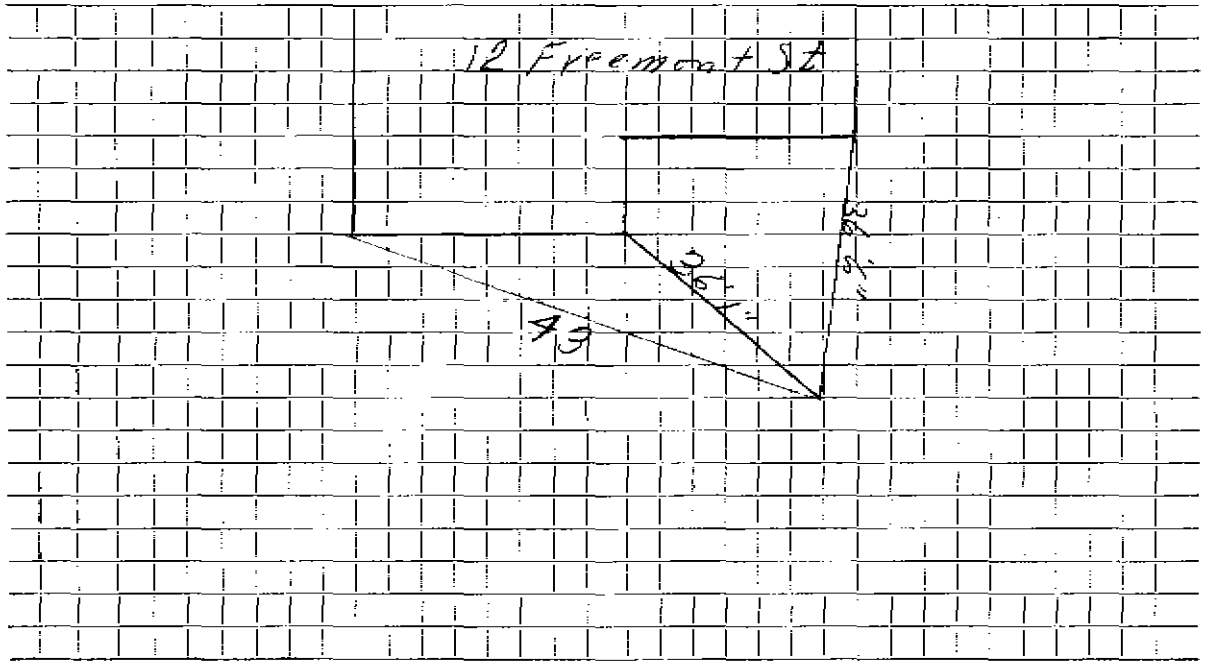

Connection made in ..... Street. Work completed .....

Remarks: .....

.....

.....