WATER SERVICE RECORD

Name

Service No. 3014

Address 20 Garfield ST

Location

Repair—Renewal—New Service J.McL

LOT 518
6" W/MAIN

Date		Material	Amount		Total		Date			Amount	
9/10/08	47'	1" Copper					9/10/08	14'	1" Copper		
								1	1" Corp		
								1	1" Curb Stop		
									buffalo box		

DATE _____

TOWN OF LEXINGTON — BOARD OF PUBLIC WORKS

WATER DIVISION

Sketch of Service Here

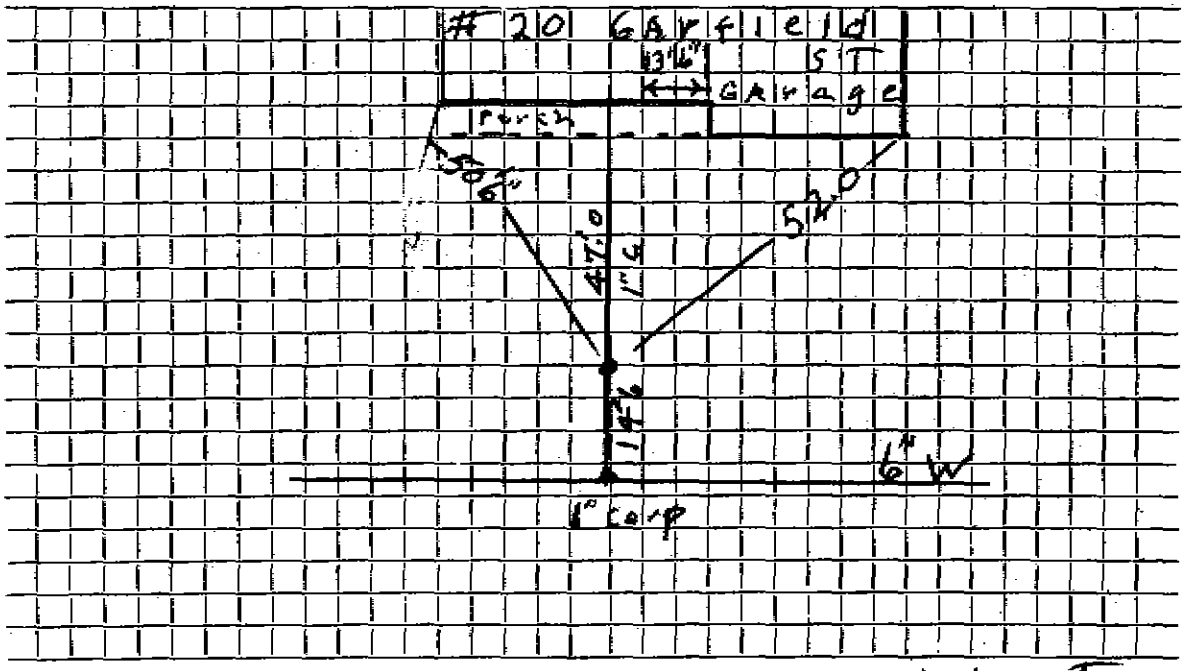

Connection made in ..... Street. Work completed 9/10/08 J. McL.

Remarks: Used To be feed from #24