R.B.M.15010

6616

WATER SERVICE RECORD

Name Duffy Bros. **Service No.**

Address 6 Goffe Road

Location

Repair—Renewal—New Service Bonanno #1181 #1103

Date		Material	Amount		Total		Date			Amount	
7/27/68	22'	3/4" Copper									
	49'	3/4" Copper									

DATE_____

TOWN OF LEXINGTON — BOARD OF PUBLIC WORKS

WATER DIVISION

Sketch of Service Here

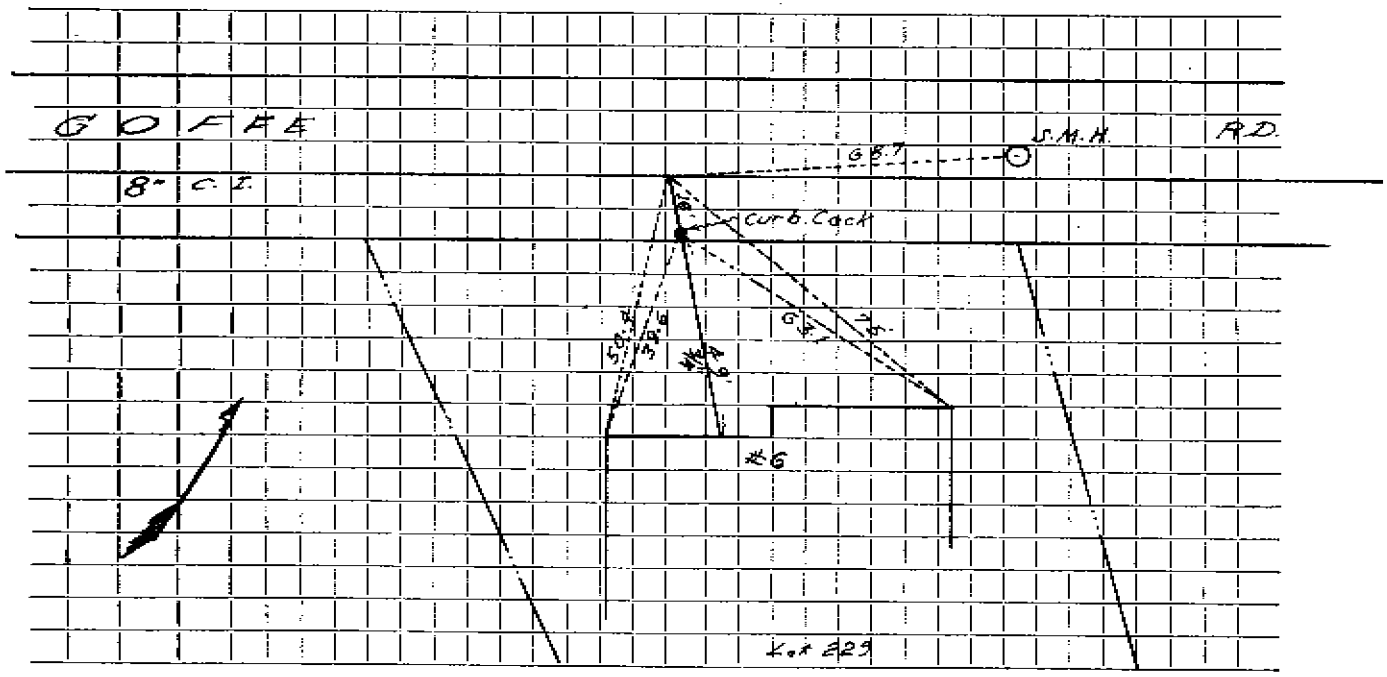

Connection made in ..... Street. Work completed .....

Remarks: .....

.....

.....