N.B.A.16010

WATER SERVICE RECORD

Name Duffy Bros. **Service No.**

Address 9 Goffe Road

Location

Repair—Renewal—New Service Bonnano #1259 #1108 #1243

Date		Material	Amount	Total	Date		Amount
11-25-68	49'	3/4" Copper tubing					
7-27-68	38'	3/4" Copper tubing					
10-31-68	44'	3/4" Copper tubing					

DATE _____

TOWN OF LEXINGTON — BOARD OF PUBLIC WORKS

WATER DIVISION

Sketch of Service Here

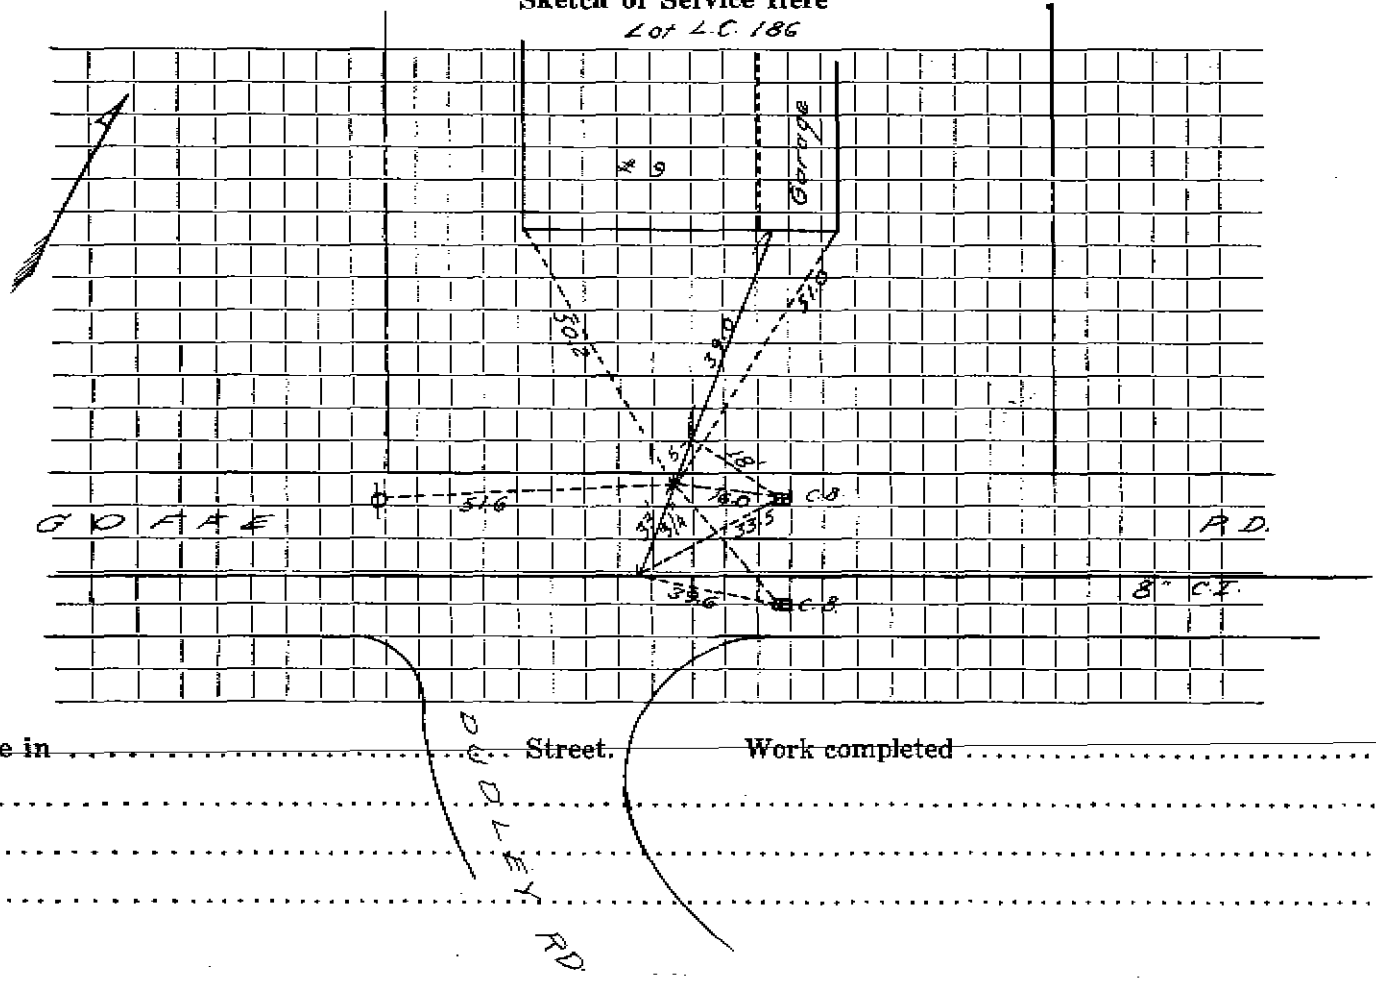

Connection made in ..... Street. Work completed .....

Remarks: .....

.....

.....