WATER SERVICE RECORD

Name **Service No.**

Address S Goodwin Road (in hancock street)

Location S6-60-10T

Repair—Renewal—New Service Main to Curbstop 7/25/12 Fironese Defelice

Date		Material	Amount	Total	Date		Amount
8-1-12	164'	1" Copper					
		1" - Cor-P+12'	1" copper				
	2	1" Curb-Stop					
	1	1" - Union					
	2	buffalo box					
Existing							
		1" - Iron To House					

DATE _____

TOWN OF LEXINGTON — BOARD OF PUBLIC WORKS

WATER DIVISION

Sketch of Service Here

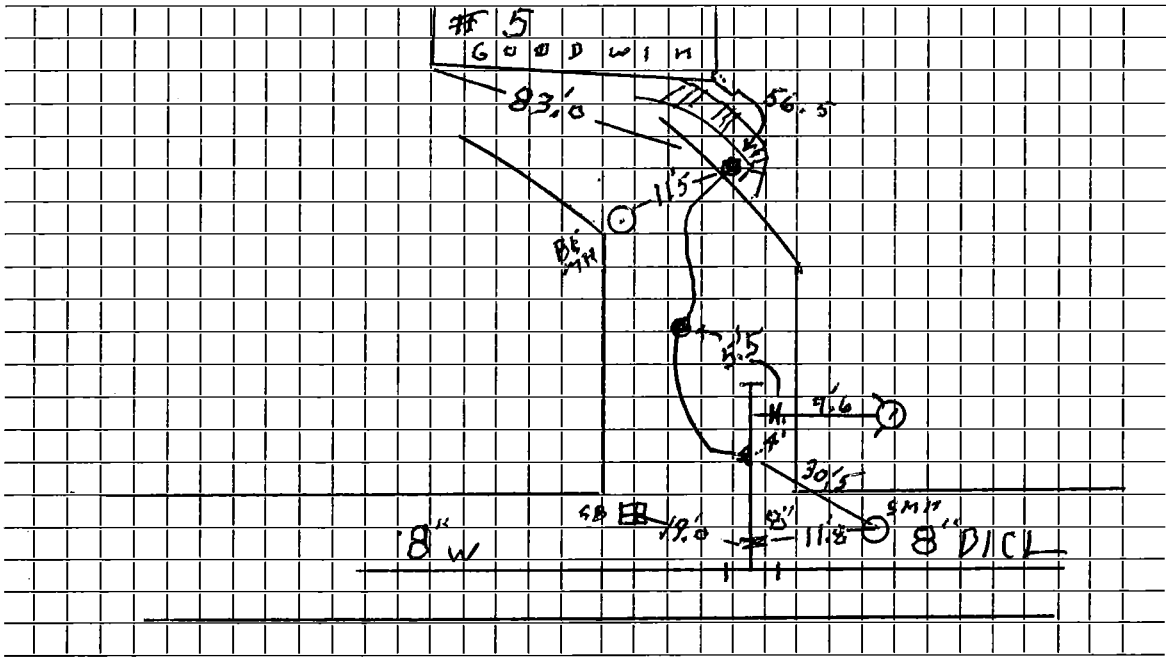

Connection made in Goodwin RD. Street. Work completed 8-1-12

Remarks: 2nd curb to house iron pipe

.....

.....