S.3.N.15010

#3248

WATER SERVICE RECORD

Name **Service No.**

Address 18 Grant Place

Location

Repair—Renewal—New Service

Date	Material	Amount	Total	Date			Amount
						OUTSIDE	
				1984	15'	1" Copper tubing	
						1" Corporation	
						1" Curb	
						Box & Rod	

DATE _____

TOWN OF LEXINGTON — BOARD OF PUBLIC WORKS

WATER DIVISION

Sketch of Service Here

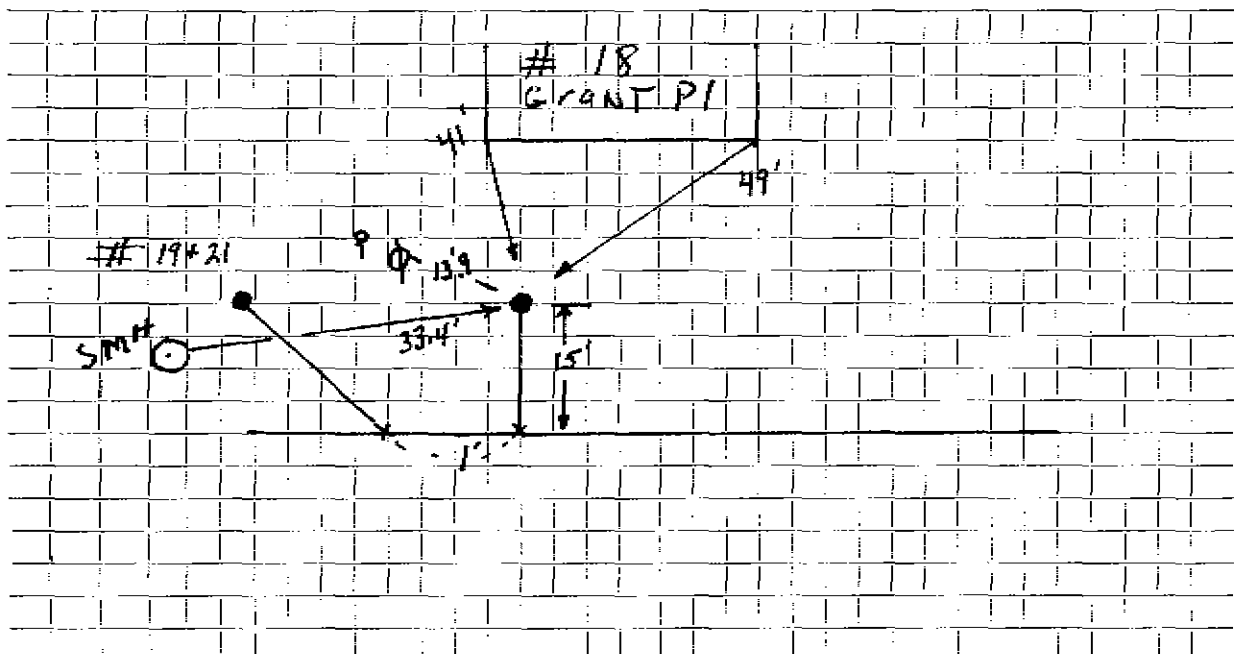

Connection made in ..... Street. Work completed .....

Remarks: 1" ~~is T'ed out to old 2½" Gate Pipe~~ .....

.....

.....