WATER SERVICE RECORD

Name **Service No.**

Address 26 GRANT ST.

Location

Repair—Renewal—New Service

Date		Material	Amount	Total	Date			Amount
7/94	52	LF 1" COPPER			7·15·97		4 LF 1" COPPER	
	1	1" C/S BUFFALO				1	1"-UNION	
		BOX				1	1" CORPORATION	

DATE _____

TOWN OF LEXINGTON — BOARD OF PUBLIC WORKS

WATER DIVISION

Sketch of Service Here

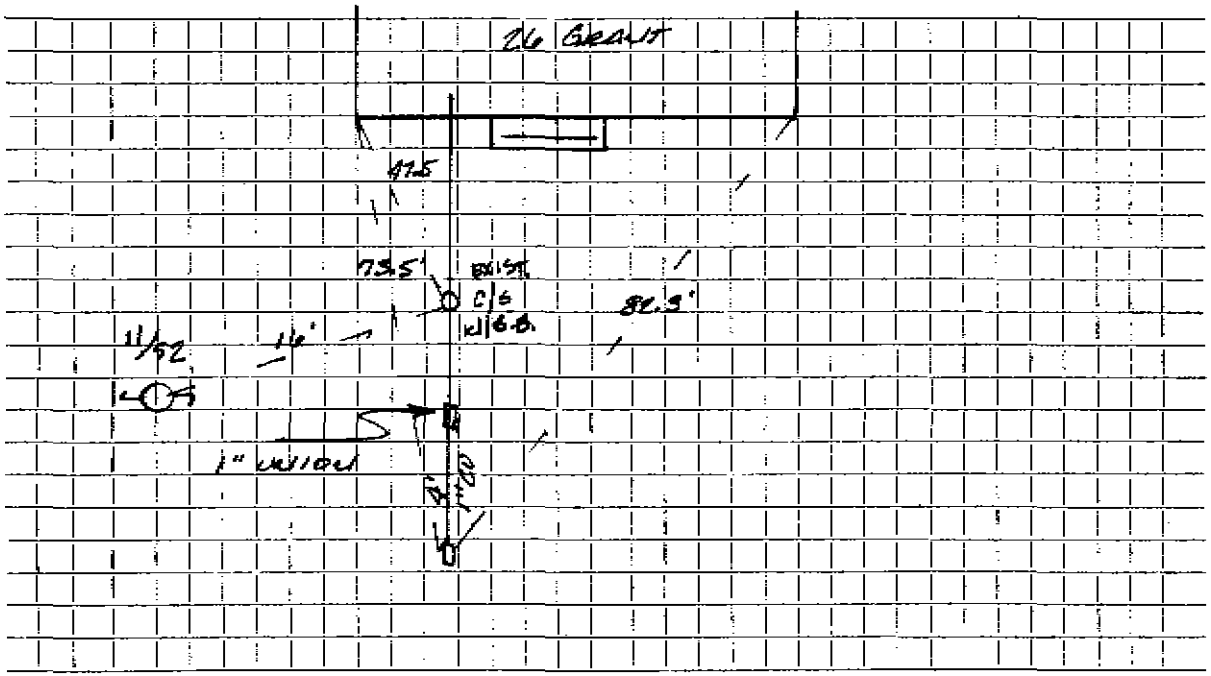

Connection made in ..... Street. Work completed .....

Remarks: .....ORIGINAL.....SERVICE.....7.94.....

.....

.....