WATER SERVICE RECORD

Name **Service No.**

Address 67 GRANT STREET

Location

Repair—Renewal—New Service

Date		Material	Amount	Total	Date		OUTSIDE	Amount
4-10-28	34	LF 1" CLP			9.16.96	25	LF 1" COPPER	
						1	1" C/S W/BUFFALO BOX	
						1	1"X3/4" UNION	
						1	1" CORPORATION	

DATE _____

TOWN OF LEXINGTON — BOARD OF PUBLIC WORKS

WATER DIVISION

Sketch of Service Here

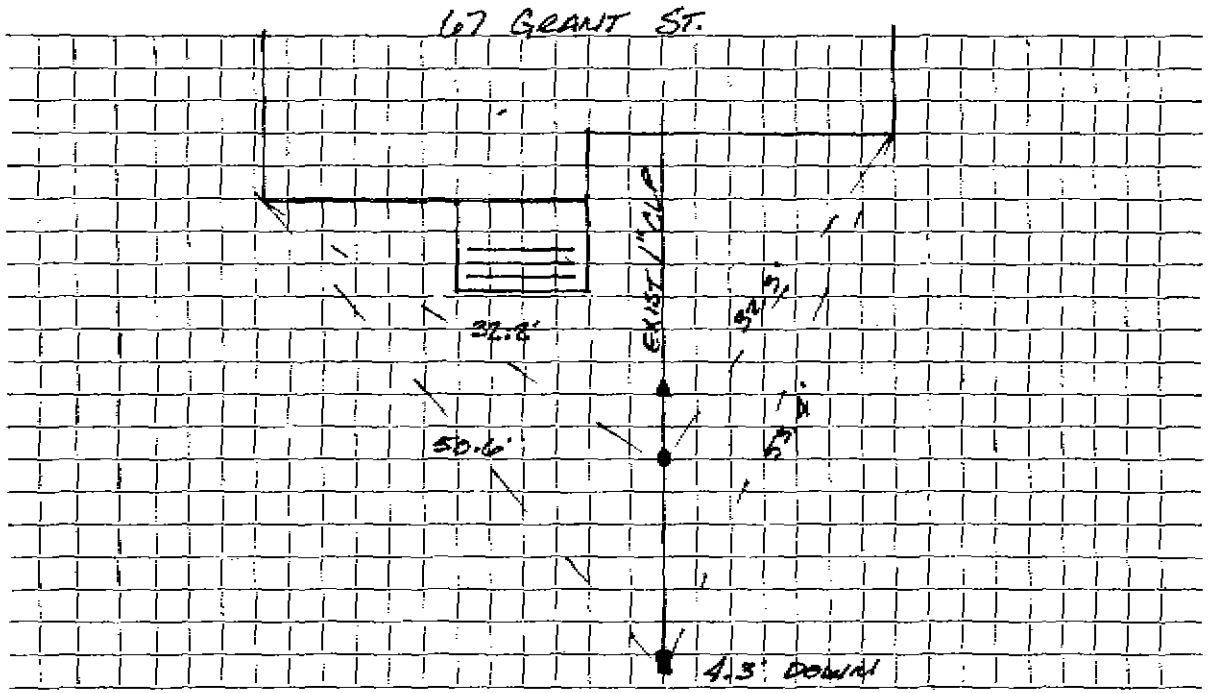

Connection made in ..... Street. Work completed .....

Remarks: ORIGINAL SERVICE 4.10.28