WATER SERVICE RECORD

Name

Service No.

Address 73 GRANT STREET

Location

Repair—Renewal—New Service FROM C/S TO MAIN

Date	Material	Amount	Total	Date	OUTSIDE	Amount
	INSIDE					
	NO INFO.			9.17.96	29 LF 1" COPPER	
					1 - 1" CORPORATION	
					1 - 1" C/S W/ BUFFALO BOX	
					1 - 1"X3/4" UNION	

DATE 9.17.96

TOWN OF LEXINGTON — BOARD OF PUBLIC WORKS

WATER DIVISION

Sketch of Service Here

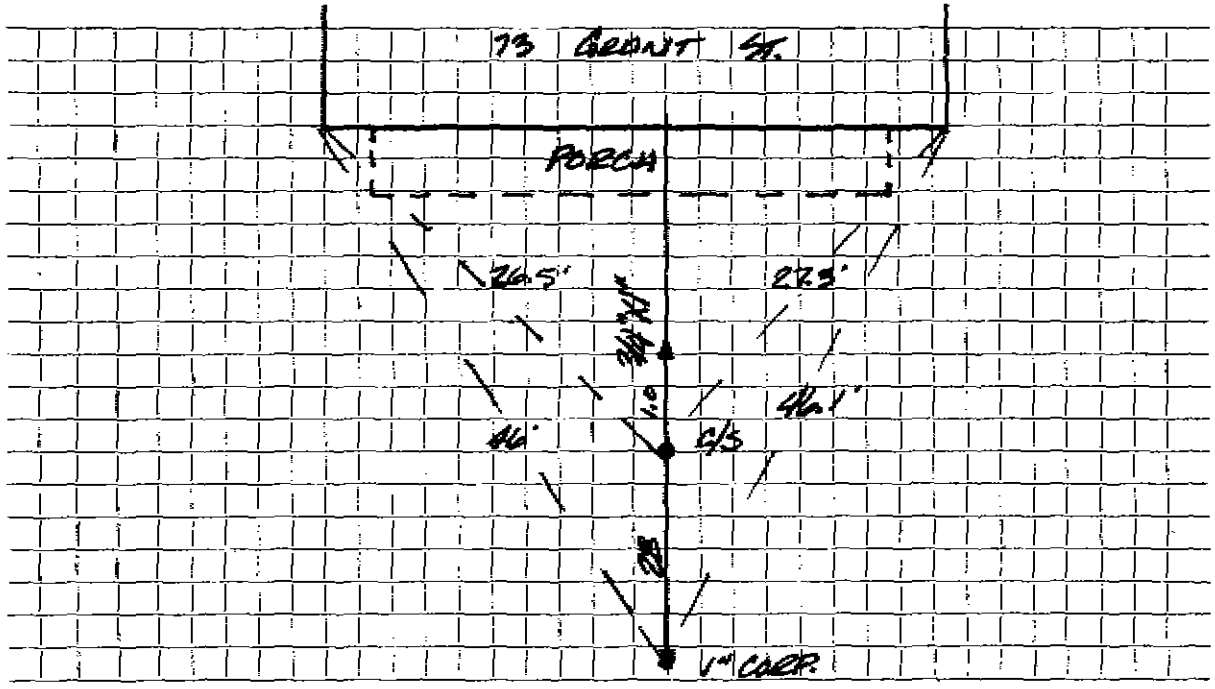

Connection made in ..... Street. Work completed .....

Remarks: ORIGINAL SERVICE 7.22.70