WATER SERVICE RECORD

Name | **Service No.**

Address 78 Grant ST

Location

Repair—Renewal—New Service Slaughter

Date	Material	Amount	Total	Date		Amount
12/06	1" copper			9/25/05-38'	1" copper	
					1" corp	
					1" curb stop	
					buffalo box	

DATE _____

TOWN OF LEXINGTON — BOARD OF PUBLIC WORKS

WATER DIVISION

Sketch of Service Here

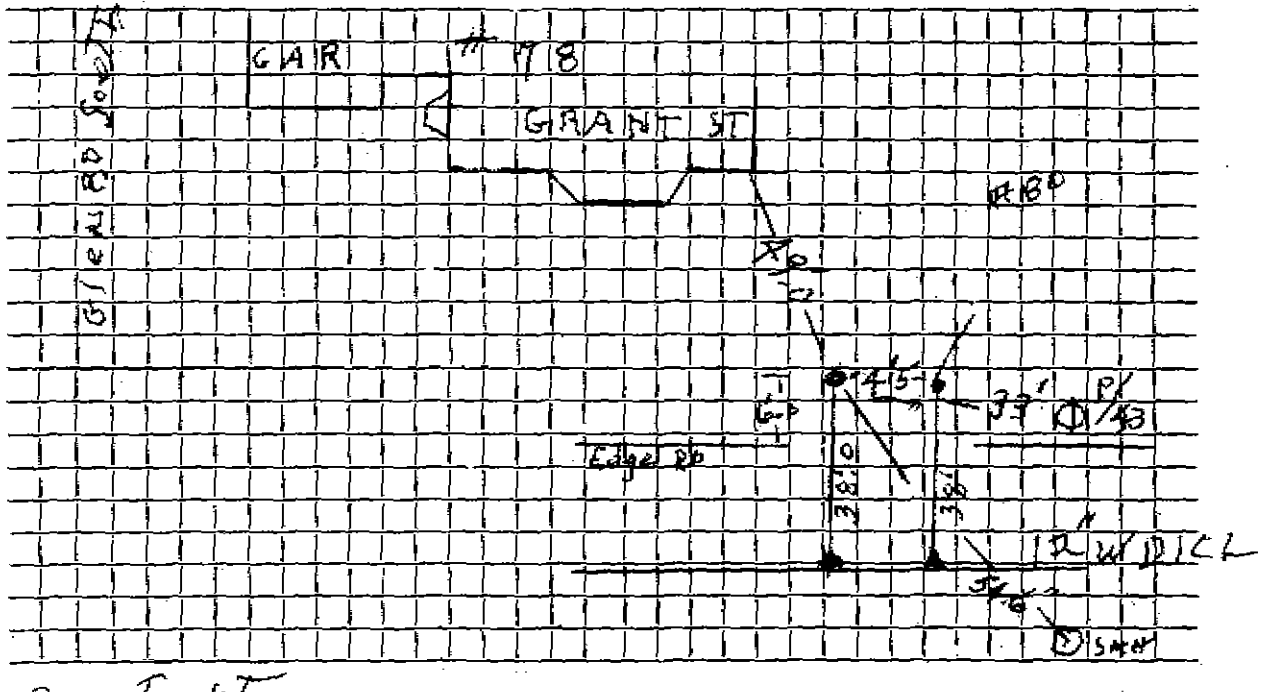

Connection made in Grant ST Street. Work completed .....

Remarks: .....