WATER SERVICE RECORD

Name Diamond West Realty **Service No.**

Address 16 Grassland Street

Location Dig Safe # 973-400971

Repair—Renewal—New Service Permit No. # 1032 A. Cardillo Contractor

Date	Material	Amount	Total	Date		Amount
				11-12-	97	20.2 1" copper
						1 curbstop
						1 corporation

DATE 11-12-97

TOWN OF LEXINGTON — BOARD OF PUBLIC WORKS

WATER DIVISION

Sketch of Service Here

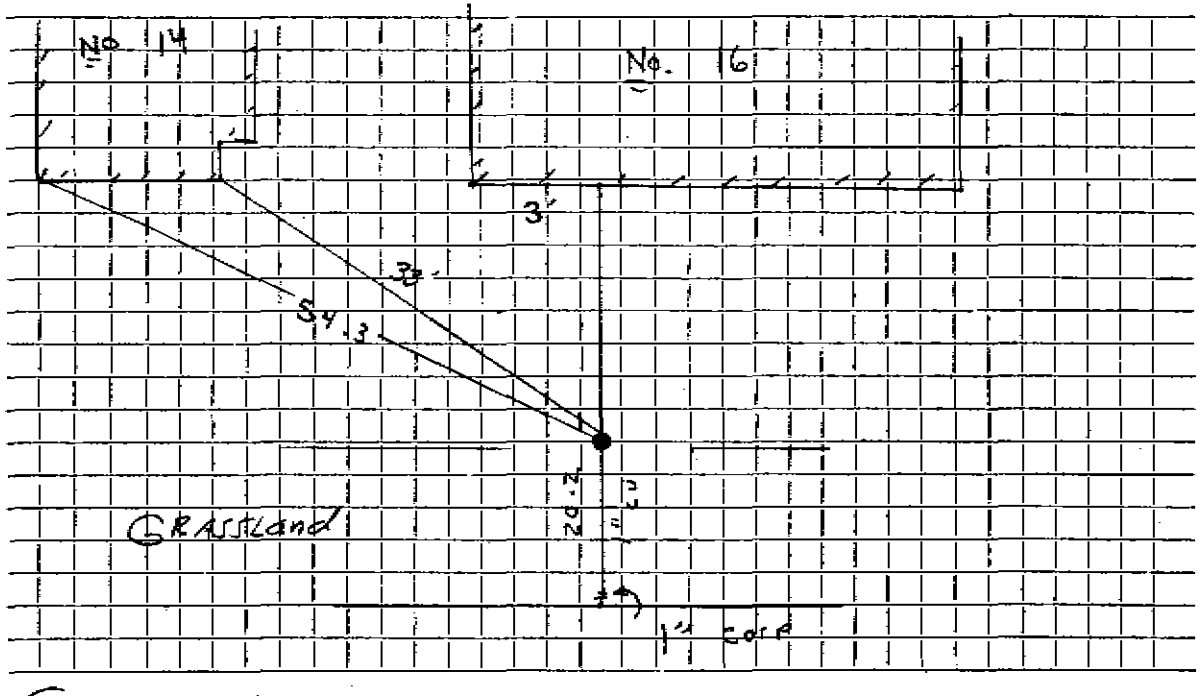

Connection made in Grassland Street. Work completed .....

Remarks: .....