WATER SERVICE RECORD

Name | **Service No.**

Address 40 GROVE ST.

Location

Repair—Renewal—New Service CJ Par Sons #91-10

Date		OUTSIDE	Amount	Total	Date		IN	Amount
9-24-	92	34.3 LF 1" COPPER			1/28/53			
		1" CURB w/ Box				68'	3/4 COPPER	
		1" UNION					3/4 x 1/2 SAW	
		1" CORP.				1	3/4 UNION ~ 3 PART	
		3/4" x 1" RED.						

DATE_____

TOWN OF LEXINGTON — BOARD OF PUBLIC WORKS

WATER DIVISION

Sketch of Service Here

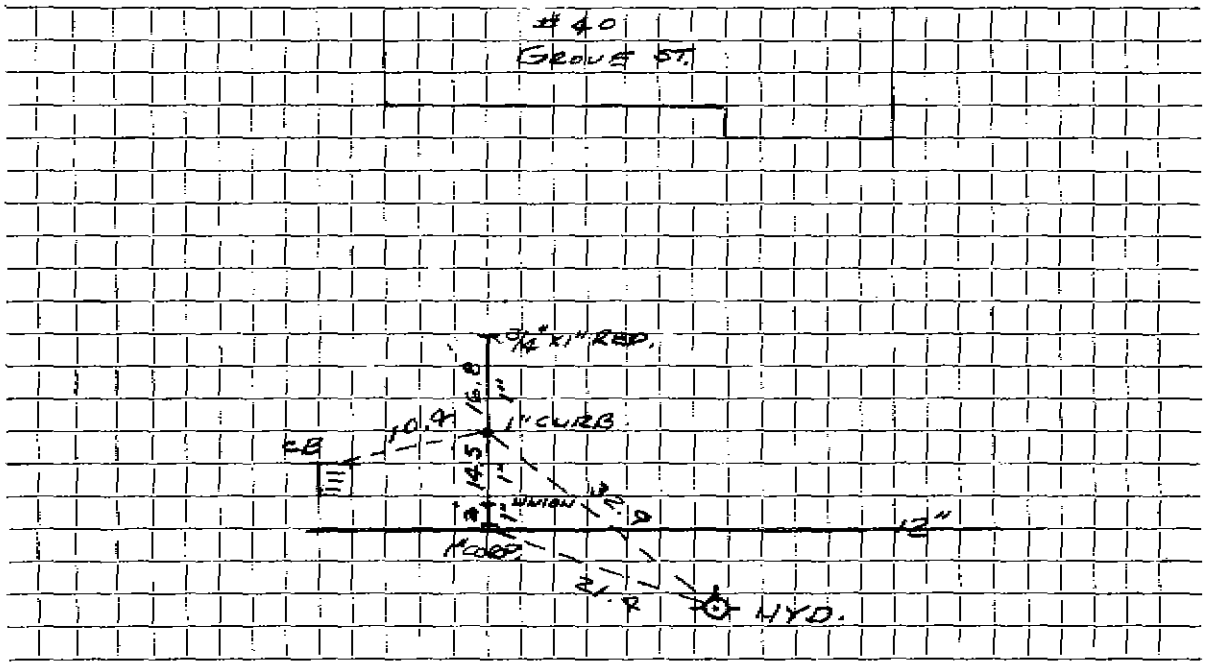

Connection made in GROVE Street. Work completed .....

Remarks: 3/4" INSIDE