R.B.M.16010

#4258

WATER SERVICE RECORD

Name Harold C. Wilson **Service No.**

Address 2 Hadley Road

Location Sta 0+66 L

~~Repair-Renewal~~ **New Service** J.M.Lucente Permit #A193

Date		Material	Amount		Total		Date			Amount	
5-7-66	53'	3/4" Copper tubing									

DATE _____

TOWN OF LEXINGTON — BOARD OF PUBLIC WORKS

WATER DIVISION

Sketch of Service Here

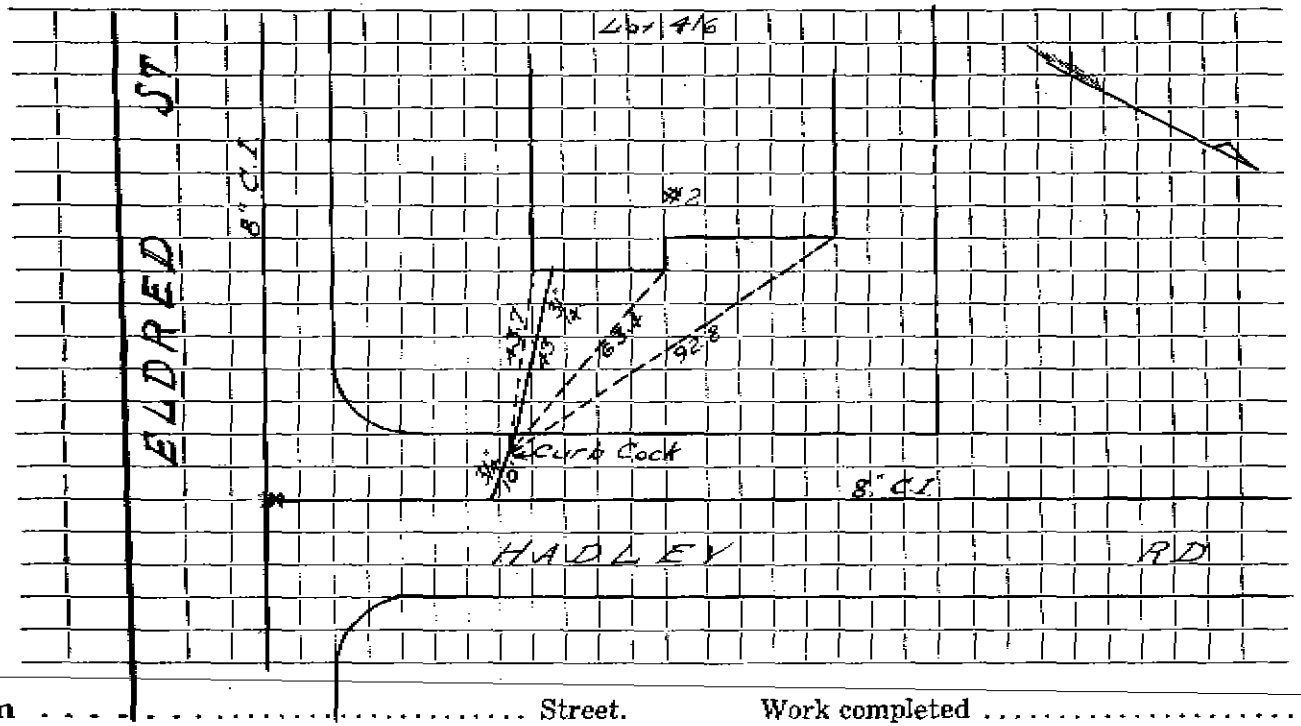

Connection made in . . . . . Street. Work completed . . . . . .

Remarks: . . . . . .

. . . . . .

. . . . . .