R.B.W.16010

WATER SERVICE RECORD

Name Service **No.**

Address 4 Hadley Road

Location Lot #417 Sta.2+51L

Repair—Renewal—New Service J.M.Lucente Permit #A250

Date		Material	Amount		Total		Date			Amount	
5-7-66	64'	3/4" Copper tubing									

DATE _____

TOWN OF LEXINGTON — BOARD OF PUBLIC WORKS

WATER DIVISION

Sketch of Service Here

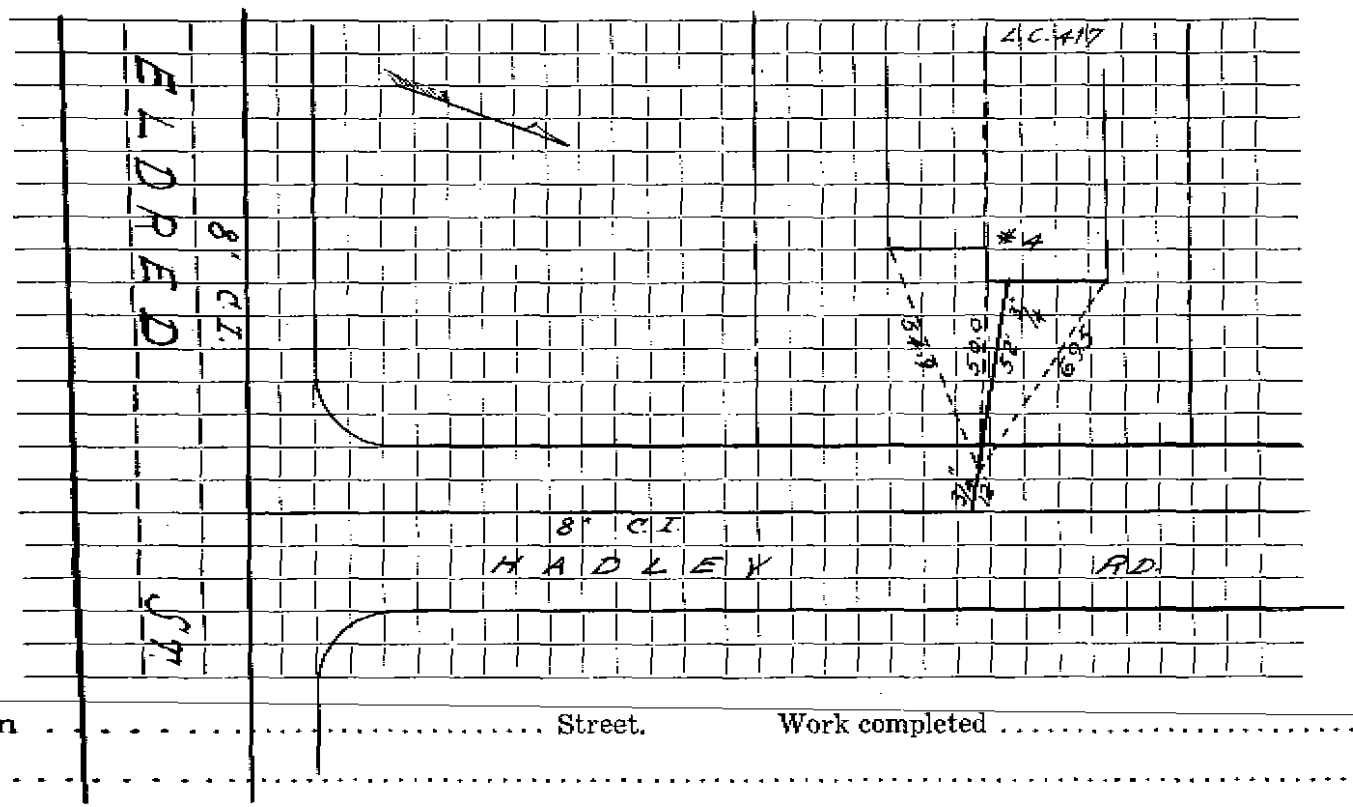

Connection made in ..... Street. Work completed .....

Remarks: .....

.....

.....