R.B.M.16010

WATER SERVICE RECORD

2308
Service No.

Name Harold Wilson

Address 8 Hadley Road

Location Lot #419 Sta.5+52L

Repair—Renewal—New Service DeFlice #875

Date		Material	Amount		Total		Date			Amount	
11-7-67	67'	3/4" Copper tubing									

DATE _____

TOWN OF LEXINGTON — BOARD OF PUBLIC WORKS

WATER DIVISION

Sketch of Service Here

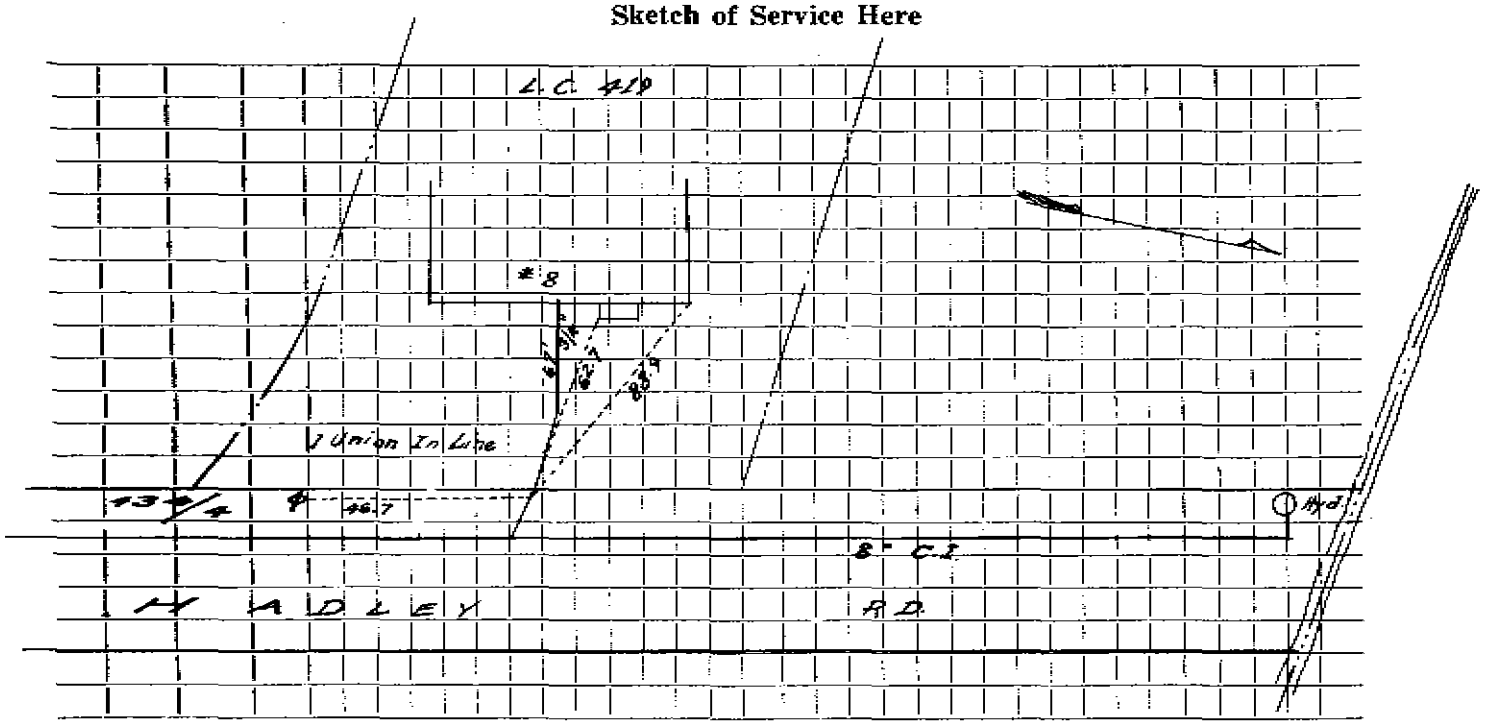

Connection made in . . . . . Street. Work completed . . . . . .

Remarks: . . . . . .

. . . . . .

. . . . . .