WATER SERVICE RECORD

Name **Service No.**

Address # 10 HANCOCK AVE.

Location

Repair—Renewal—New Service CJ PETSONS #91-10

Date	OUTSIDE	Amount	Total	Date	ARLEX	Amount
10-21-92	18 LF 1" COPPER			11-24-88		
	1" CORP.			35'	3/4 COPPER	
	1" CURB W/RED.					

DATE _____

TOWN OF LEXINGTON — BOARD OF PUBLIC WORKS

WATER DIVISION

Sketch of Service Here

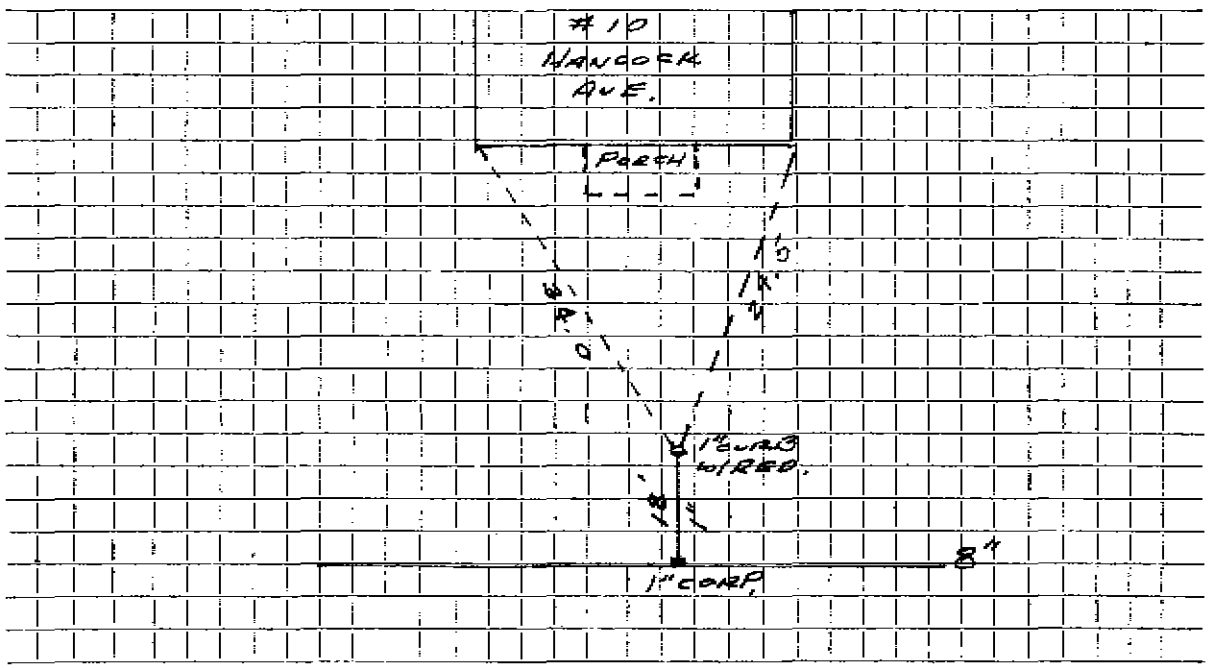

Connection made in HANCOCK AVE. Street. Work completed .....

Remarks: INSIDE SERV. 3/4"