WATER SERVICE RECORD

Name

Service No. 2514

Address 3 HANCOCK Ave

Location LOT 36

Repair—Renewal—New Service

Date		Material	Amount		Total		Date			Amount	
7/25/07	41.6	1" Copper					10/19/92	11'	1" Copper		
		buffalo box							1" Corp		
									1" Curb		

DATE _____

TOWN OF LEXINGTON — BOARD OF PUBLIC WORKS

WATER DIVISION

Sketch of Service Here

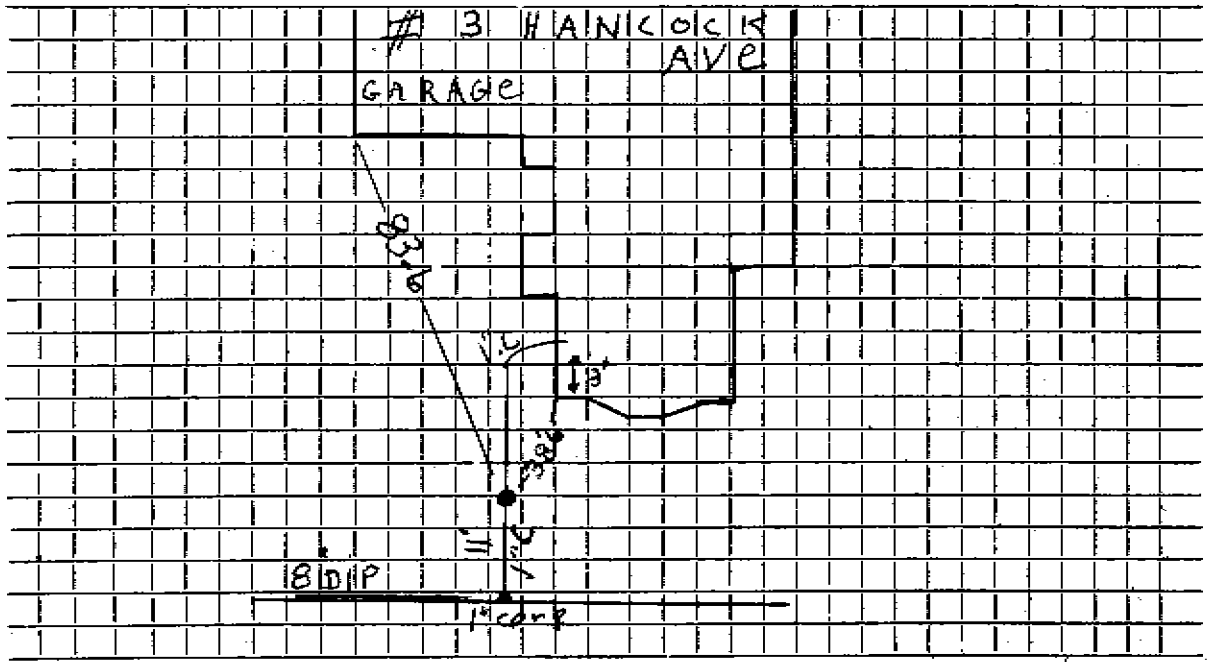

Connection made in ..... Street. Work completed 7/25/07 J. McL

Remarks: .....