WATER SERVICE RECORD

Name | **Service No.**

Address 12 Hancock street

Location S6-[redacted]-17 lot

Repair—Renewal—New Service Main to curbstop. 7/25/12 Grange Defelice

Date		Material	Amount	Total	Date		Amount
7-25-12	2'+10'	12'- 1" Copper					
		1"- Corp.					
		1" Curb STop					
		1"x 3/4" Union					
		buffalo box					
1968 Exist	11'	3/4 copper To house					
		3/4 Curb-left IN place behind fence- ON					

DATE _____

TOWN OF LEXINGTON — BOARD OF PUBLIC WORKS

WATER DIVISION

Sketch of Service Here

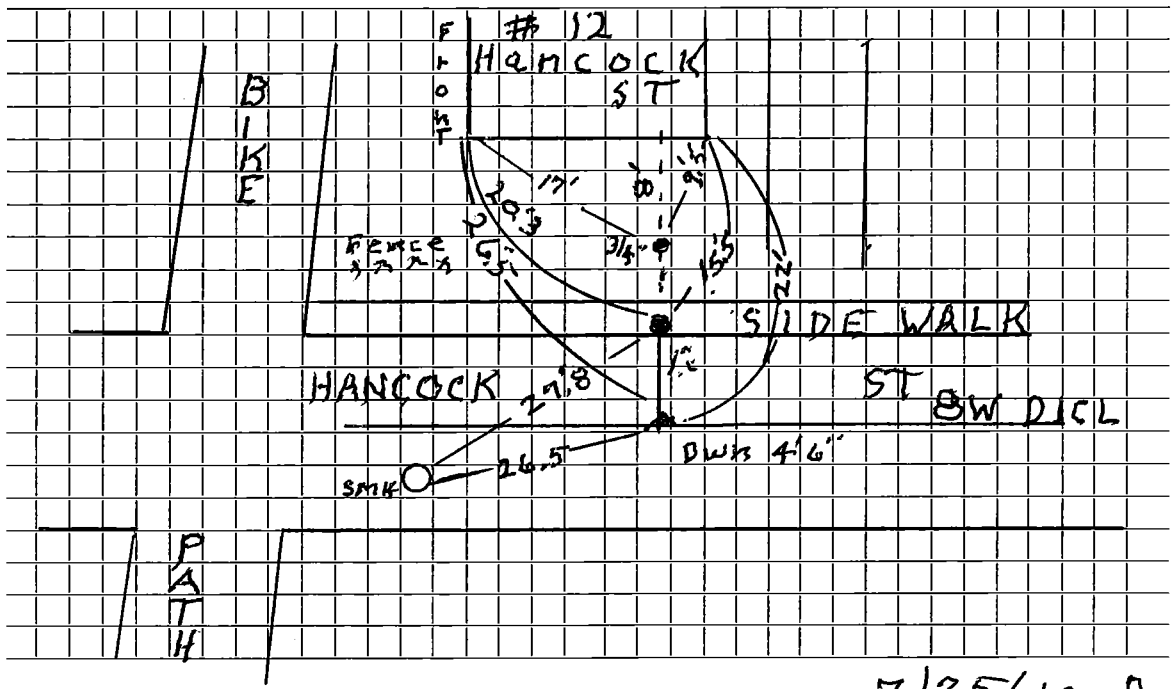

Connection made in ..... Street. Work completed 7/25/12 Perfect

Remarks: 3/4 Curb Left IN Place behind fence

.....

.....