WATER SERVICE RECORD

Name Hancock Church **Service No.**

Address 23 HANCOCK ST.

Location

Repair—Renewal—New Service MKC # 0656

Date		Material	Amount	Total	Date		Amount
5/12/93		42 LF 3/4" COPPER					
		CURB BOX					
10/29/64	25'	3/4" Copper tubing					
	1	3/4" Adapter					
	1	3/4" Curb Cock					

DATE _____

TOWN OF LEXINGTON — BOARD OF PUBLIC WORKS

WATER DIVISION

Sketch of Service Here

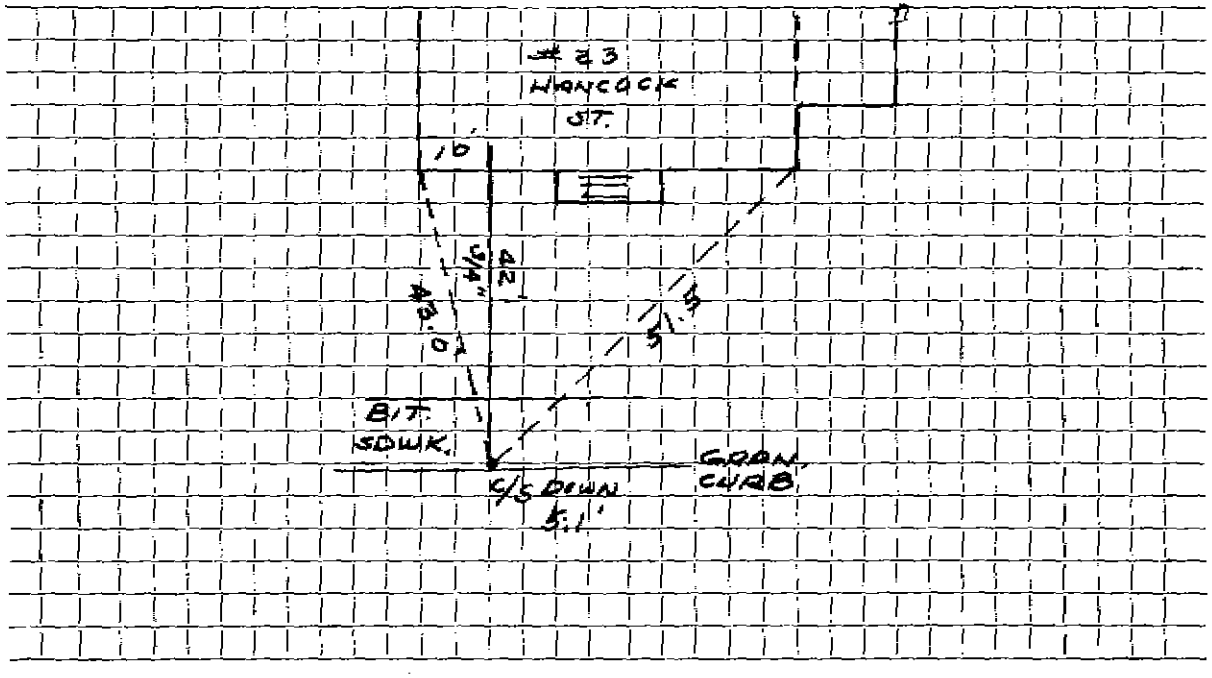

Connection made in HANCOCK Street. Work completed .....

Remarks: 1' FROM GAS SERV.