# WATER SERVICE RECORD

**Name** **Service No.**

**Address** # 61 HANCOCK ST.

**Location**

**Repair—Renewal—New Service**

| Date | Material | Amount | Total | Date | | Amount |
|---|---|---|---|---|---|---|
| 5-30-86 | 1" CORP. | | | 11/18/74 | INSIDE | |
| | 1" CURB w/BOX | | | | 178' 3/4 COPPER | |
| | 1"x3/4" ADAPTOR UNION | | | | 3/4 S+W | |
| | 32.5 LF 1" COPPER | | | | | |

DATE _____

TOWN OF LEXINGTON — BOARD OF PUBLIC WORKS

## WATER DIVISION

Sketch of Service Here

61 HANCOCK

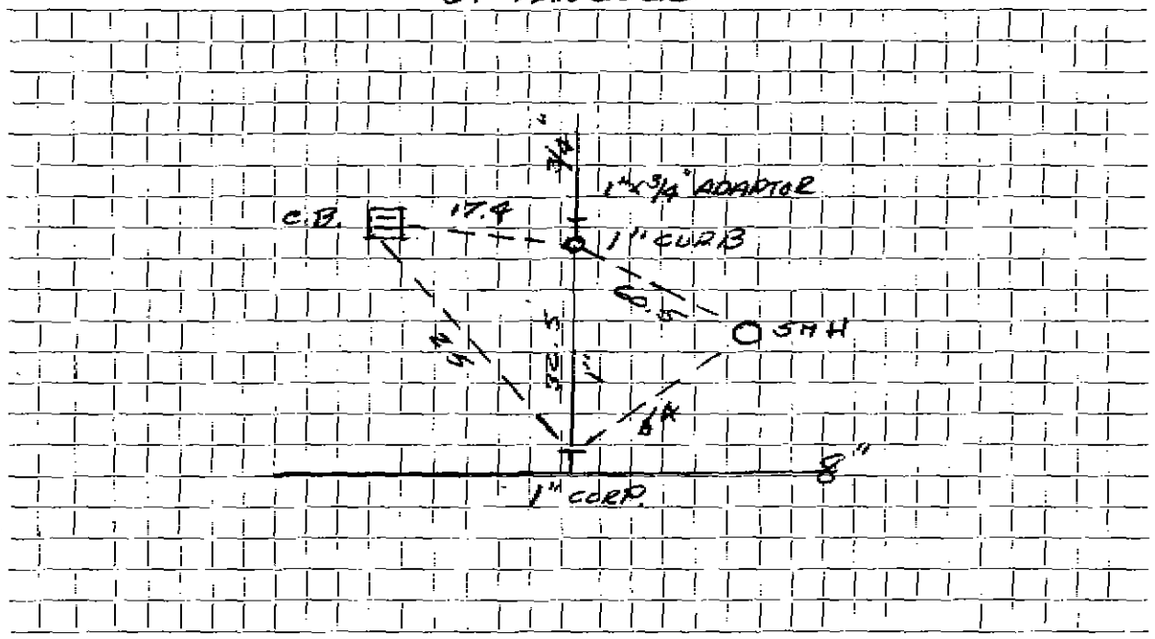


Connection made in HANCOCK Street. Work completed .....

Remarks: NEW 8" D.I. MAIN, NEW COPPER SERV.