Main to curb [redacted] r [redacted]wal

WATER SERVICE RECORD

Name

Service No. #5744, 5745

Address 43 Hayes Avenue

Location Lexington, Mass.

~~Repair~~—Renewal—~~New Service~~ Redmond #3964

Date		Material	Amount	Total	Date		Amount	
6/18/80	35'	6" 3/4" Copper tubing						
						NON CHARGE		
					8/7/51	Labor	4	22
						15' -3/4" copper tubing@.326	4	89
						1 - 3/4" C. adapter	1	82
						1 -3/4" ck 3/4" C. curb-cock	4	67
						1 hr. trucking		75
							16	35

HP-8855

DATE _____

TOWN OF LEXINGTON — BOARD OF PUBLIC WORKS

WATER DIVISION

Sketch of Service Here

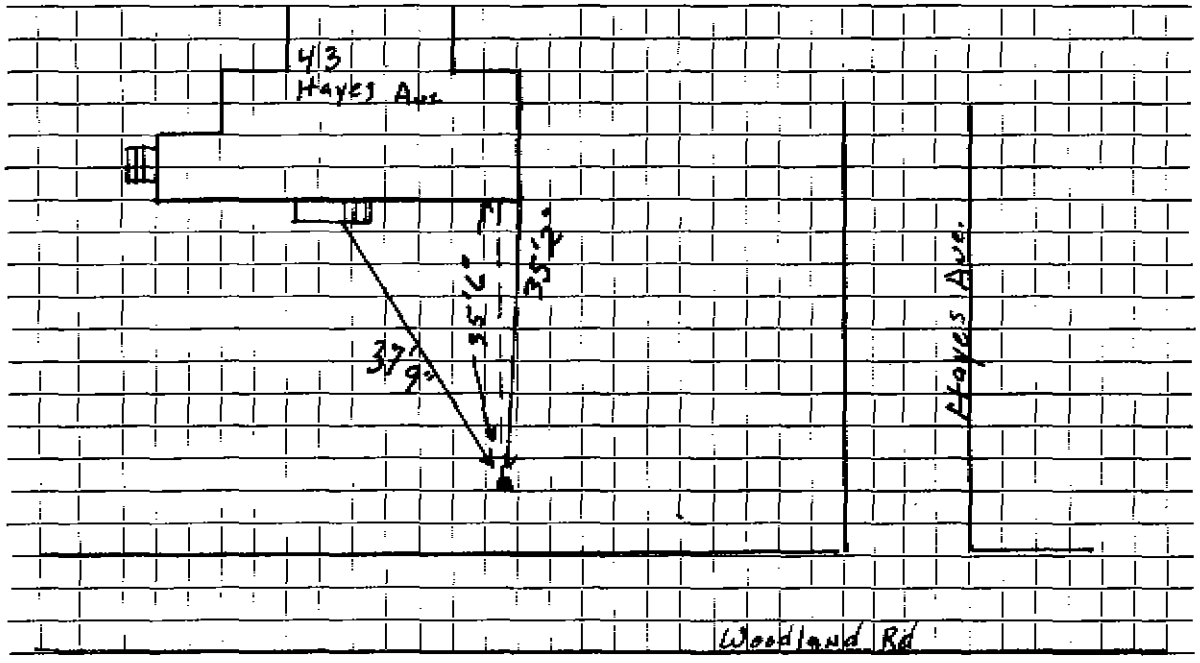

Connection made in Woodland Rd. 35'6" inside Street. Work completed .....

Remarks: ¾" 15' outside

.....

.....