R.B.M.16010

WATER SERVICE RECORD

Name Ralph Hall **Service No.**

Address 17 Heritage Drive

Location Lot #16

~~**Repair Renewal**~~ **New Service** DeFlice #1697
John Melone & Sons, Cont. Permit #1151

Date		Material	Amount		Total		Date			Amount	
~~8/2/68~~	~~36'~~	~~3/4" Copper tubing~~					8-2-68				
8-7-70	85'	3/4" Copper tubing						36'	3/4" Copper		

DATE _____

TOWN OF LEXINGTON — BOARD OF PUBLIC WORKS

WATER DIVISION

Sketch of Service Here

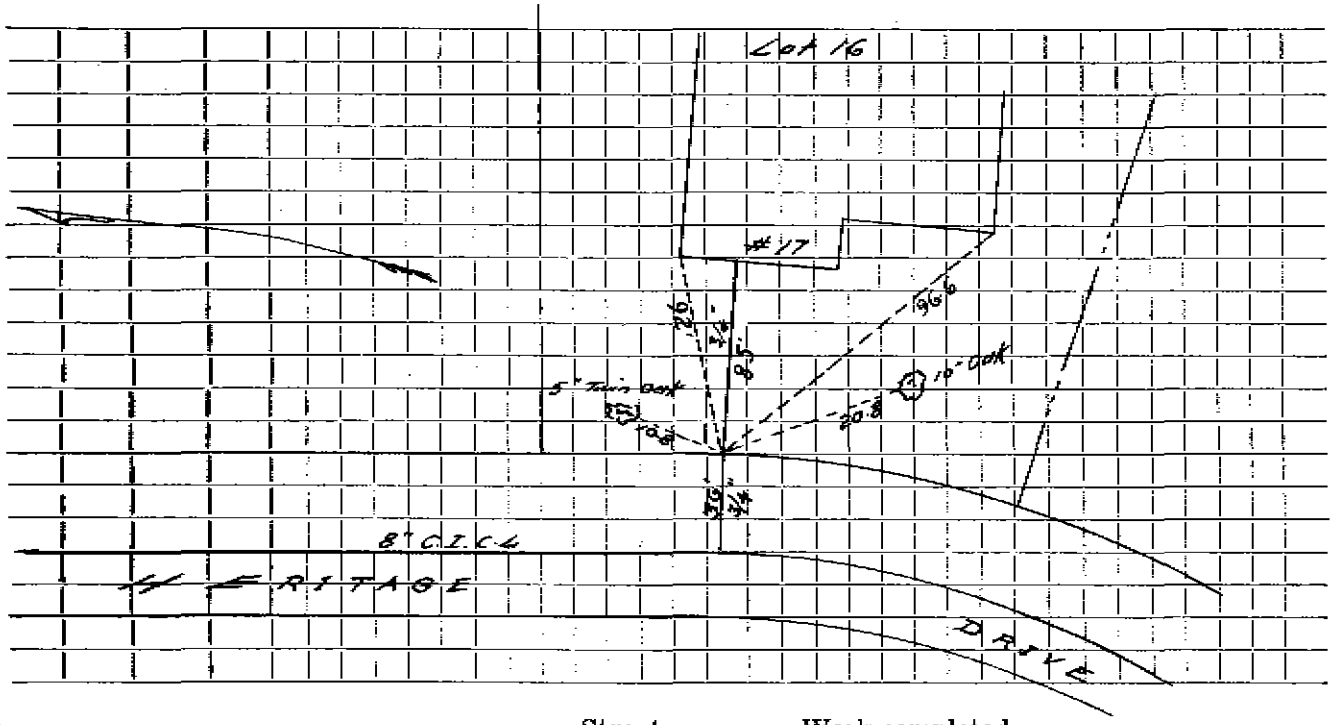

Connection made in ..... Street. Work completed .....

Remarks: .....

.....

.....