N.B.W.16010

WATER SERVICE RECORD

Name Ralph Hall **Service No.**

Address 22 Heritage Drive #3422

Location Lot #20 DeFlice #1751

~~**Repair - Renewal**~~ **New Service** John Melone & Sons, Cont. Permit #1146

Date		Material	Amount	Total	Date		Amount
8/2/68	18'	3/4" Copper tubing					
10-14-70	85'	3/4" Copper tubing					

DATE _____

TOWN OF LEXINGTON — BOARD OF PUBLIC WORKS

WATER DIVISION

Sketch of Service Here

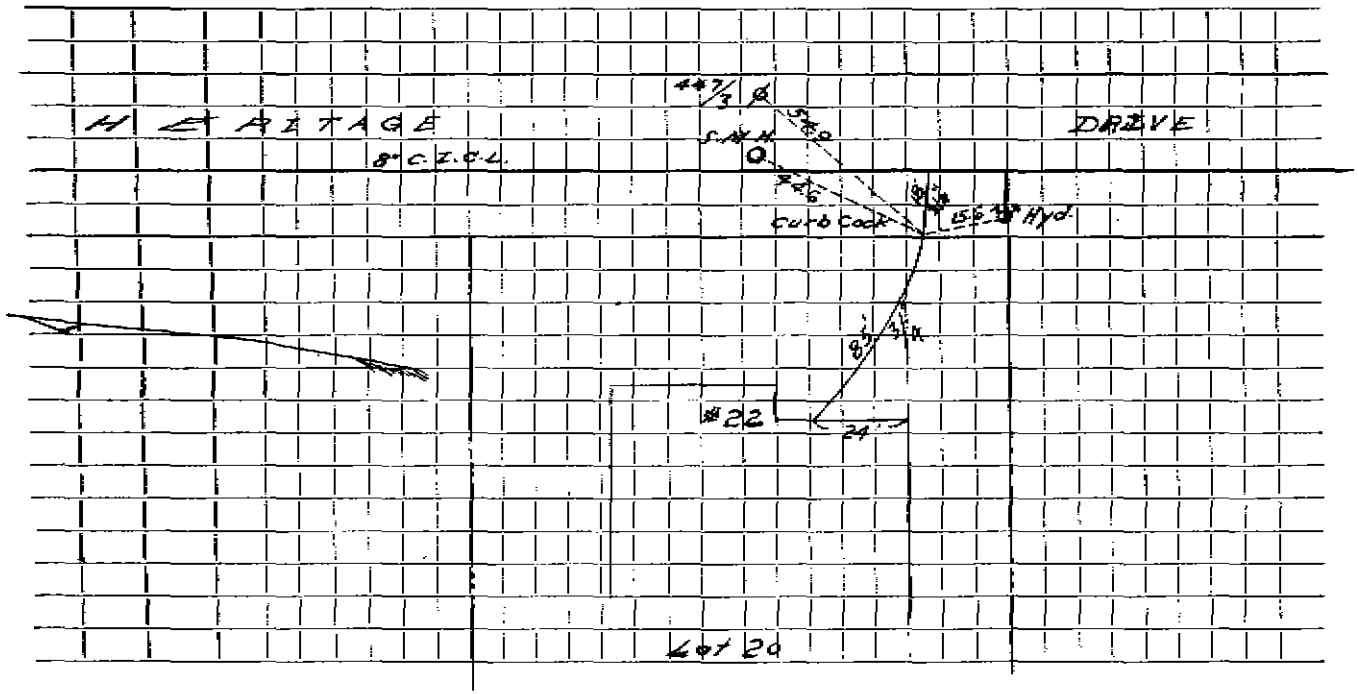

Connection made in ..... Street. Work completed .....

Remarks: .....

.....

.....