R.B.M.-15010

#-5722

WATER SERVICE RECORD

Name Ralph Hall **Service No.**

Address 9 Heritage Drive

Location Lot #13

~~Repair~~ ~~Renewal~~ New Service John Melone & Sons, Cont. Permit #1154 **DeFlice permit #2077**

Date		Material	Amount	Total	Date		Amount
8/2/68	36'	3/4" Copper tubing					
6/20/72	178'	3/4" Copper					

DATE _____

TOWN OF LEXINGTON — BOARD OF PUBLIC WORKS

WATER DIVISION

Sketch of Service Here

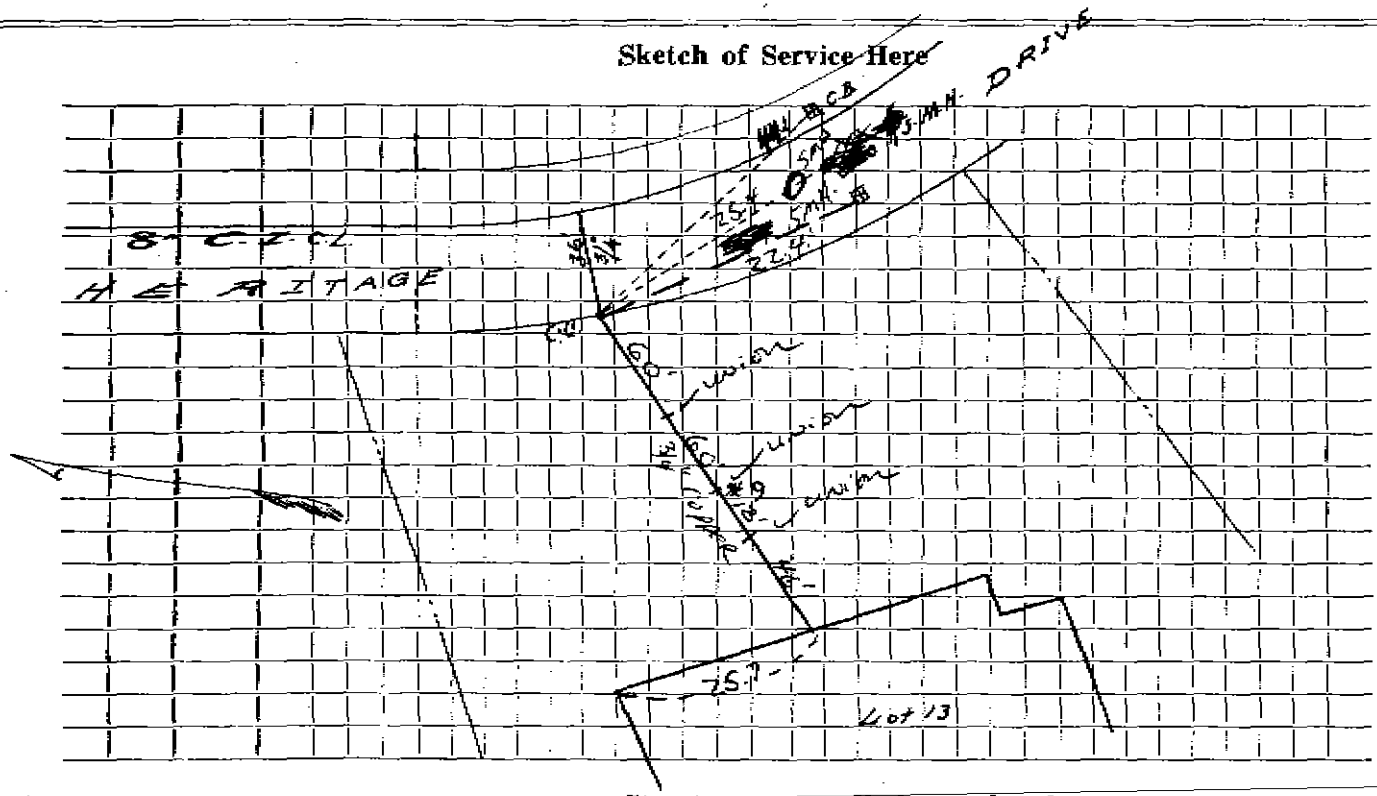

Connection made in ..... Street. Work completed .....

Remarks: .....

.....

.....