WATER SERVICE RECORD

Name

Service No.

Address 15 Hibbert ST

Location

LoT 6

Repair—Renewal—New Service

Date		Material	Amount		Total		Date			Amount	
?		1"- Iron Pipe					9/1/09	43'	1" Copper		
									1" Corp		
									1" Curb Stop		
									1"x1" Union		
									buffe box		

DATE

TOWN OF LEXINGTON — BOARD OF PUBLIC WORKS

WATER DIVISION

Sketch of Service Here

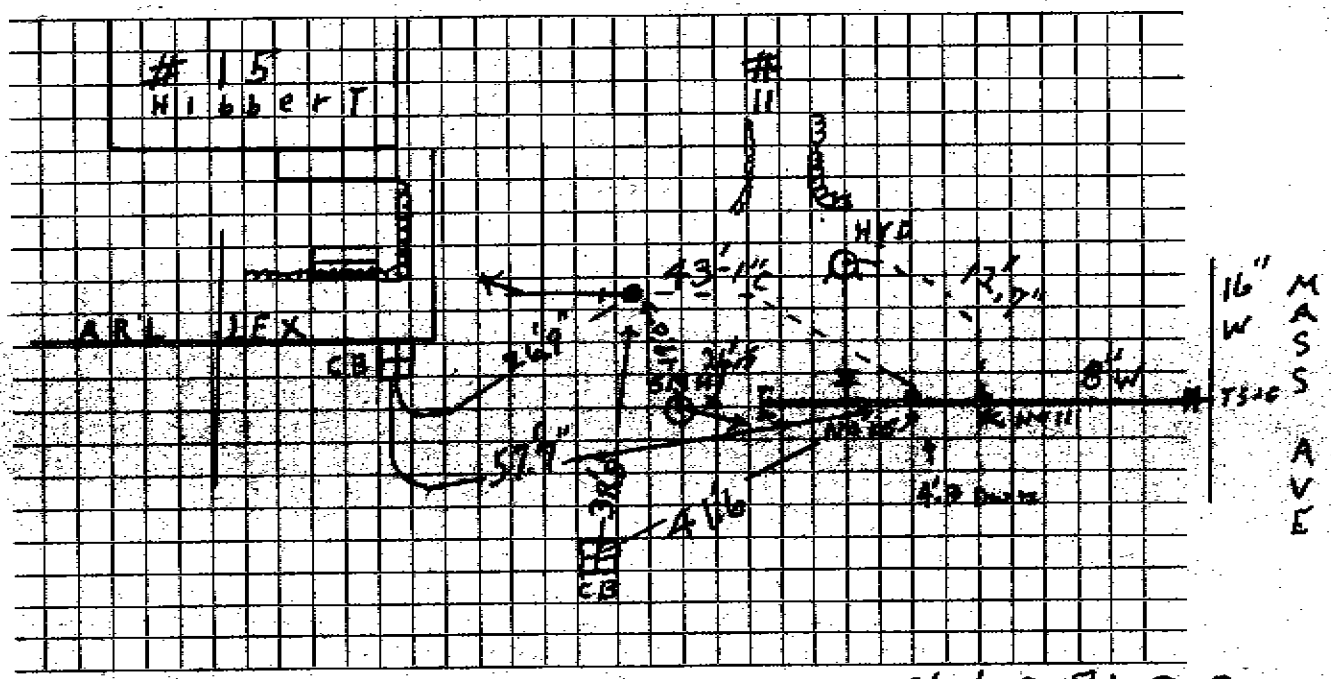

Connection made in ..... Street, " Work completed 9/1/09 P.A.O. Corp

Remarks: Curb DWN 4'9" / Corp DWN 4'8" Curb To house 1" Steel Pipe. West of Swanson..