WATER SERVICE RECORD

Name *Oscar Cormier* **Service No.**

Address *5 Meade Circle*

Location *Lot #20*

~~**Repair**~~—~~**Renewal**~~—**New Service** *Cormier #4783*

Date		Material	Amount		Total		Date			Amount	
11/21/89	*144'*	*1" Copper*									
	2	*Unions*									
		Corp.									
		c/c & Box									

DATE _____

TOWN OF LEXINGTON — BOARD OF PUBLIC WORKS

WATER DIVISION

#5 MEAD CIRCLE

Sketch of Service Here

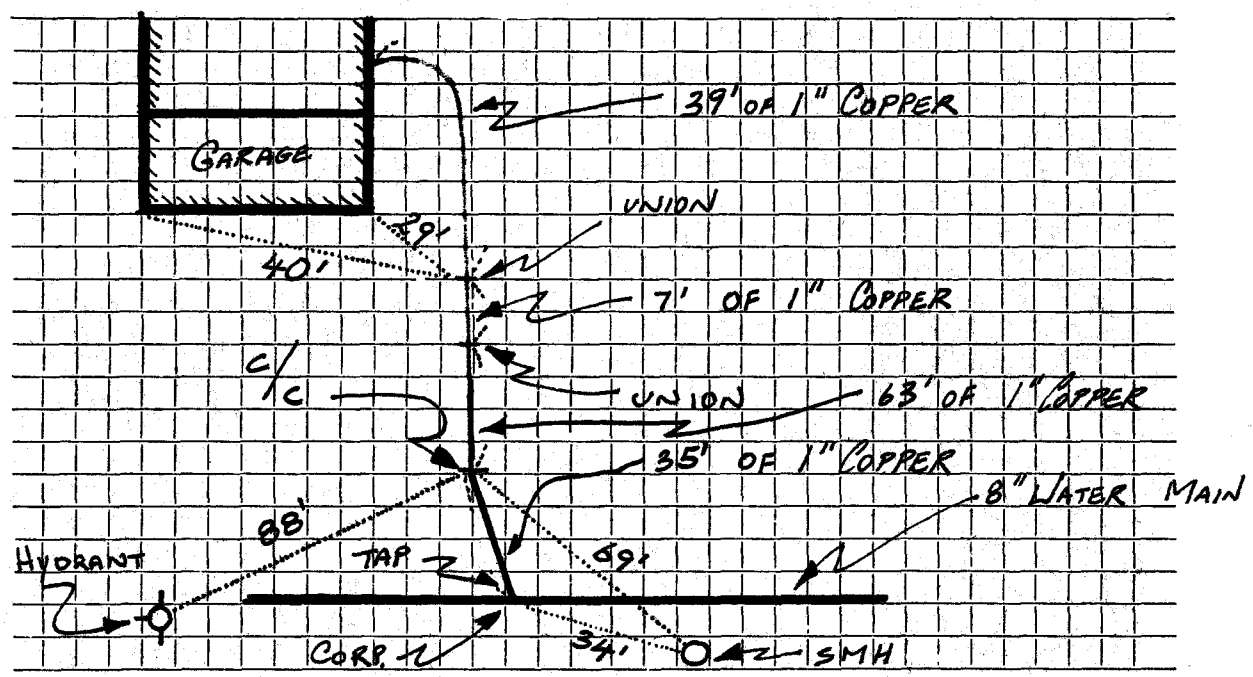

Connection made in ...MEAD...CIRCLE.... ~~Street~~. Work completed ...7-14-89.....

Remarks: .....

.....

.....