WATER SERVICE RECORD

Name **Service No.**

Address 99 MERIAH ST.

Location

Repair—Renewal—New Service

Date	OUT Material	Amount	Total	Date	IN	Amount
7/20/92	18 LF 1" COPPER			11/20/63	49' 3/4 COPPER	
	1" CORP.			1	3/4 x 1/2 S+W	
	1" SURB/W BOX					
	6" - 3/4" NIPPLE					
	3/4" x 1" RED.					
	3/4" COUPLING					

DATE _____

TOWN OF LEXINGTON — BOARD OF PUBLIC WORKS

WATER DIVISION

Sketch of Service Here

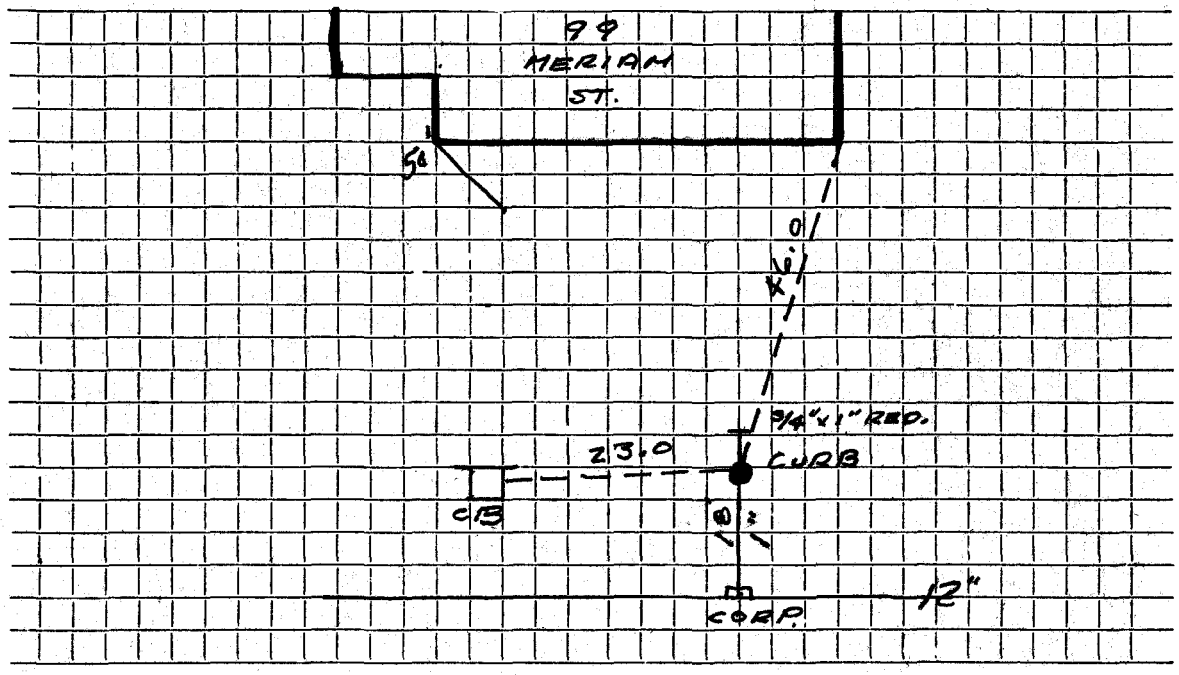

Connection made in MERIAM Street. Work completed .....

Remarks: BISZKO - O.S. CONTR.