H.B.M.16010

WATER SERVICE RECORD

Service No. 62 2695 8810

Name Jo Jen Realty Trust

Address ~~XXXXXXX~~ 29 Middle St.

Location

~~Replace Remove~~ New Service W. O. # 7189

APR 6 1970

Date		Material	Amount	Total		Date		Amount	
						12-3-69	Deposit	100	00
12/9/69		Labor		14	06	7-4-70	Refund	54	18
		10% O.H.		1	41			45	82
	9'	3/4" Copper pipe	.79	7	11				
		3/4" Corporation		9	57				
		3/4" Curb stop		8	57				
		Box & Rod		5	10				
				45	82				
8/19/70	42'	Copper tubing--Dave Eagle, permit #1702							

DATE _____

TOWN OF LEXINGTON — BOARD OF PUBLIC WORKS

WATER DIVISION

Sketch of Service Here

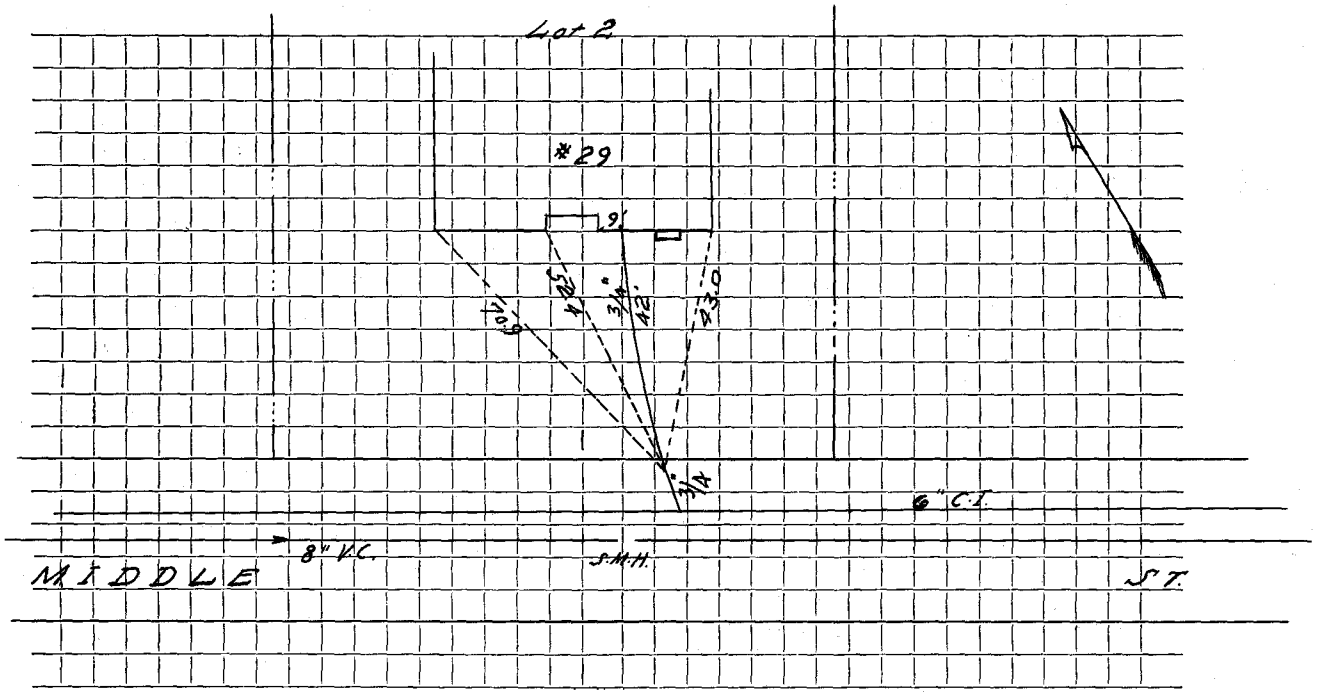

Connection made in ..... Street. Work completed .....

Remarks: .....

.....

.....