H.B.M.16010

WATER SERVICE RECORD

Name

Service No. #7051 #7362

Address 80 Middle St.

Location

Repair—Renewal—New Service

Date		Material	Amount	Total	Date		Amount
9/15/86	8"	3/4" Copper					
	1	3/4" compression curb					
	1	3/4" 3 part union					
	1	curb box & rod					

DATE _____

TOWN OF LEXINGTON — BOARD OF PUBLIC WORKS

WATER DIVISION

Sketch of Service Here

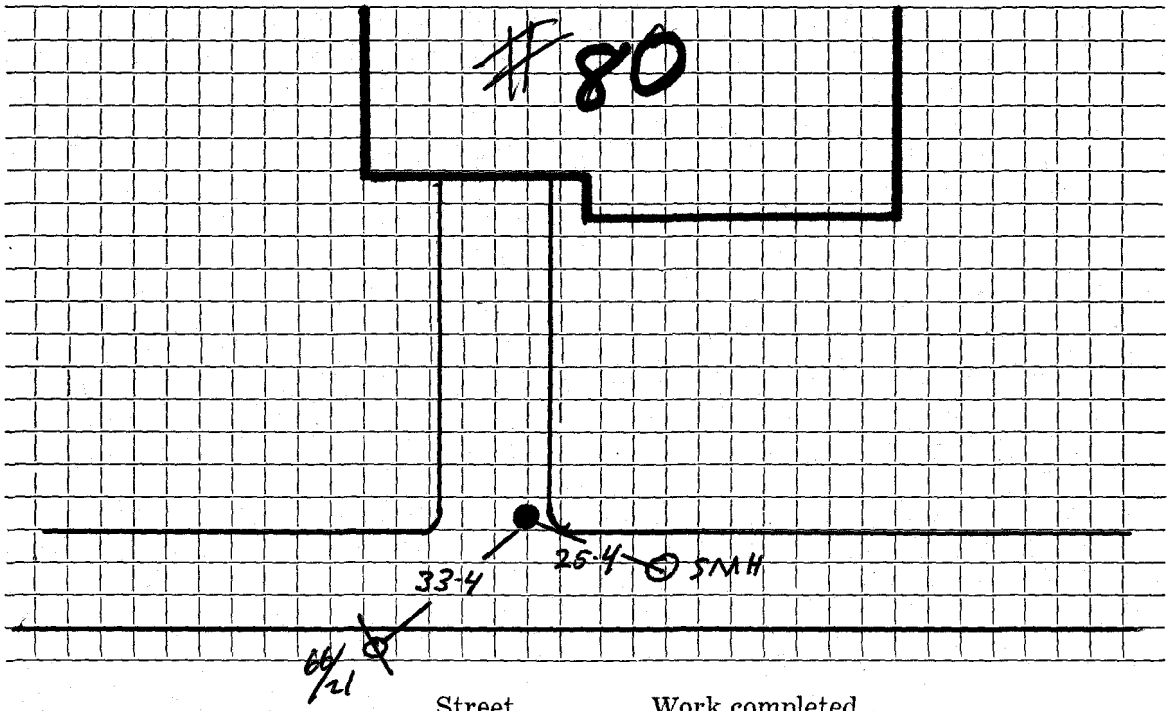

Connection made in ..... Street. Work completed .....

Remarks: .....

.....

.....