WATER SERVICE RECORD

Name **Service No.**

Address 1 MinuTe Man-LA,

Location

Repair—Renewal—New Service Defective

Date	Material	Amount	Total	Date		Left on Mass Ave	Amount
			34'	Novell	34'	1" Copper	
						1" corp	
						1" Curb Stop	
						Buffalo box	

TOWN OF LEXINGTON — BOARD OF PUBLIC WORKS

DATE

Location HSR & MINUTE MAN LANE Date 10 NOV 11

Project / Client LEXINGTON, MA

1" Copper water service

THOM 2713 35

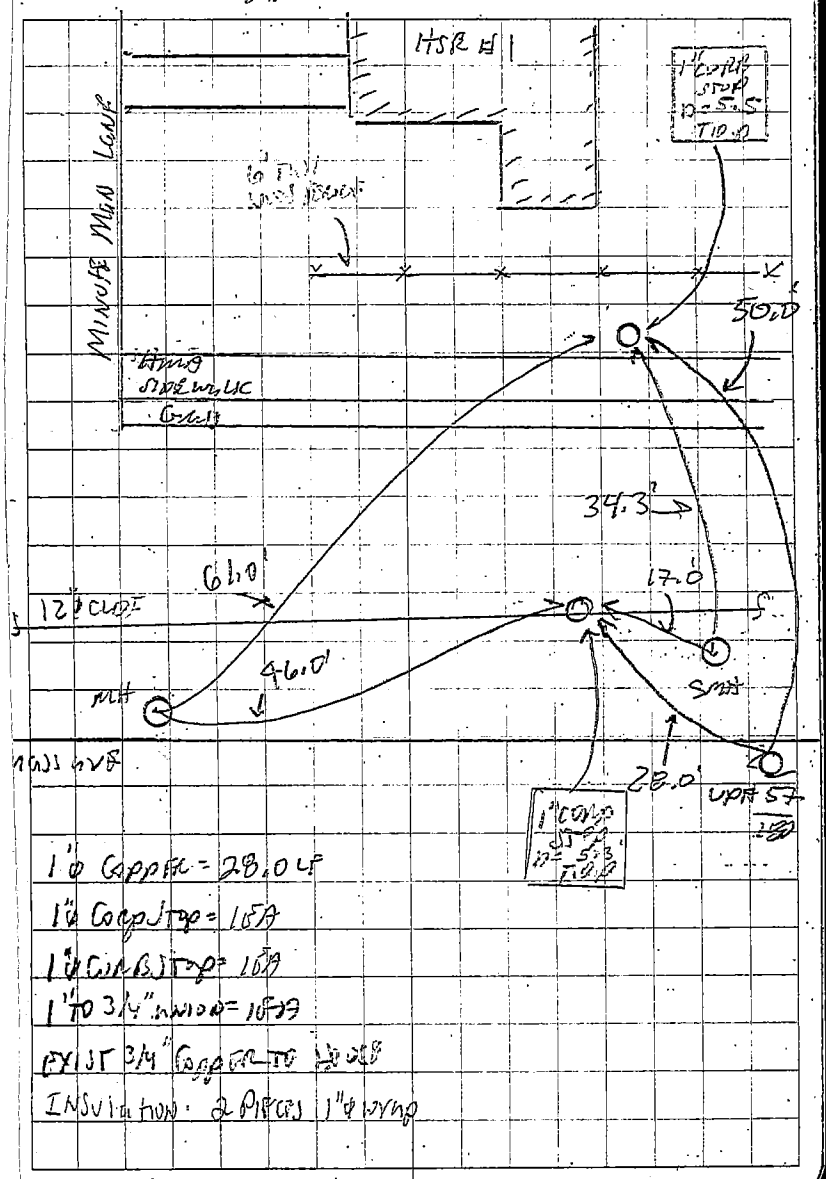

1" ø Copper = 28.0 LF

1" ø Copper = 1EA

1" ø Curb Stop = 1EA

1" to 3/4" Union = 1EA

EXIST 3/4" Copper to be reused

Installation: 2 pieces 1" ø Copper