H.B.M.16010

#908

WATER SERVICE RECORD

Name Gleason Realty Trust **Service No.**

Address 4 Mohawk Drive

Location

~~XXRenewal-Renewal~~-New Service J.M.Lucente Permit #101 Lucente #1097

Date		Material	Amount		Total		Date			Amount	
Nov.'64	25'	3/4" Copper tubing									

DATE _____

TOWN OF LEXINGTON — BOARD OF PUBLIC WORKS

WATER DIVISION

Sketch of Service Here

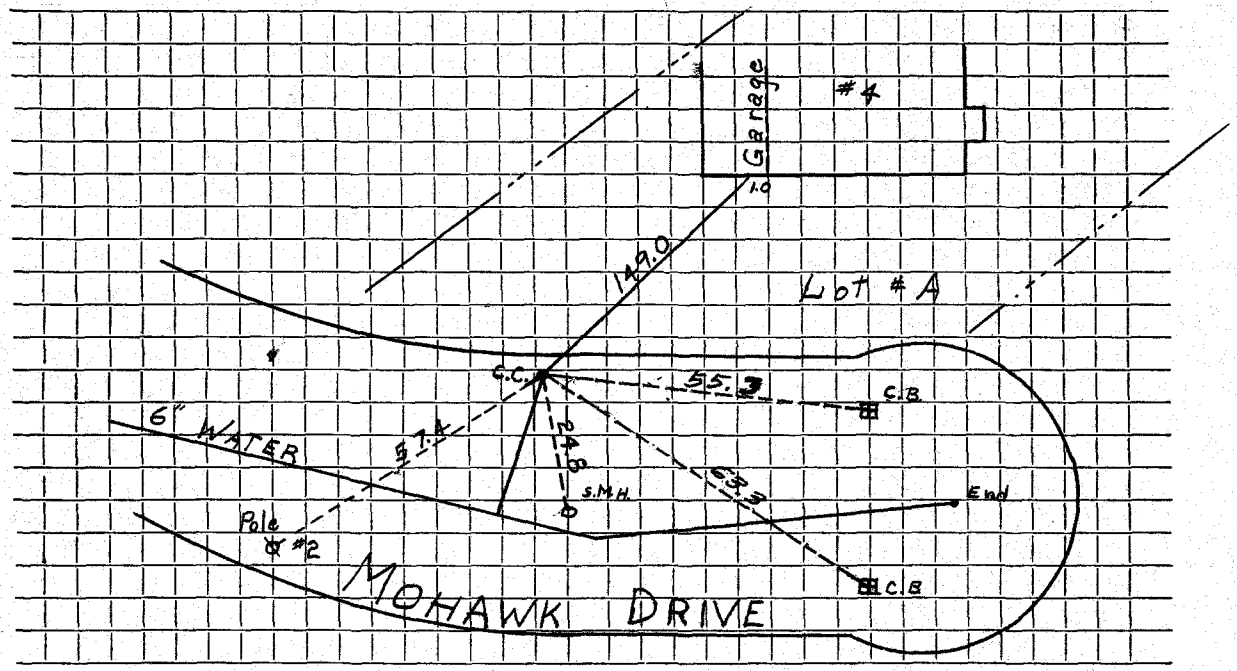

Connection made in ..... Street. Work completed .....

Remarks: .....

.....

.....