WATER SERVICE RECORD

Name

Service No.

Address 12 Moon Hill RD

Location LoT 84

Repair—Renewal—New Service

Date		Material	Amount	Total	Date		PAO-Corp	Amount
8/22/49	173'	1" Copper			6/4/09	25'	1" Copper	
	2	1" Unions (3 Part)					1" Corp	
							1" Curb Stop	
8/6/61	55'	1" Copper				1	1" Union	
	1	1" Comp. Valve					buffalo box	
	1	1"x1" - 2 Part Unions						
	2	1" - 3 Part Unions						

DATE _____

TOWN OF LEXINGTON — BOARD OF PUBLIC WORKS

WATER DIVISION

Sketch of Service Here

#12 Moon Hill RD

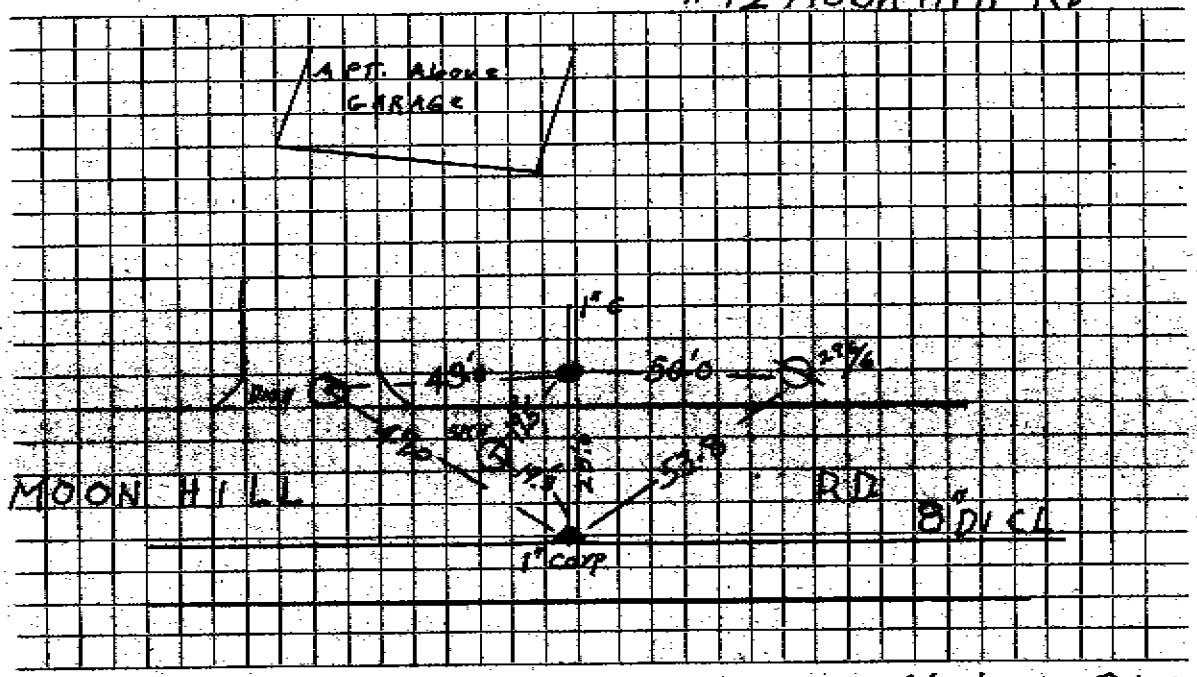

Connection made in ..... Street. Work completed 6/4/09 PAO. Corp.

Remarks: .....