H.B.M.16010

#8731

WATER SERVICE RECORD

Name Jenkins Realty Inc. **Service No.**

Address 25 Nickerson Road

Location Lot #15

Repair—Renewal—New Service DeFlice #886
Lucente Permit #637

Date		Material	Amount		Total		Date			Amount	
6/13/67	25'	3/4" Copper									
2-9-68	60'	3/4" Copper tubing									

DATE _____

TOWN OF LEXINGTON — BOARD OF PUBLIC WORKS

WATER DIVISION

Sketch of Service Here

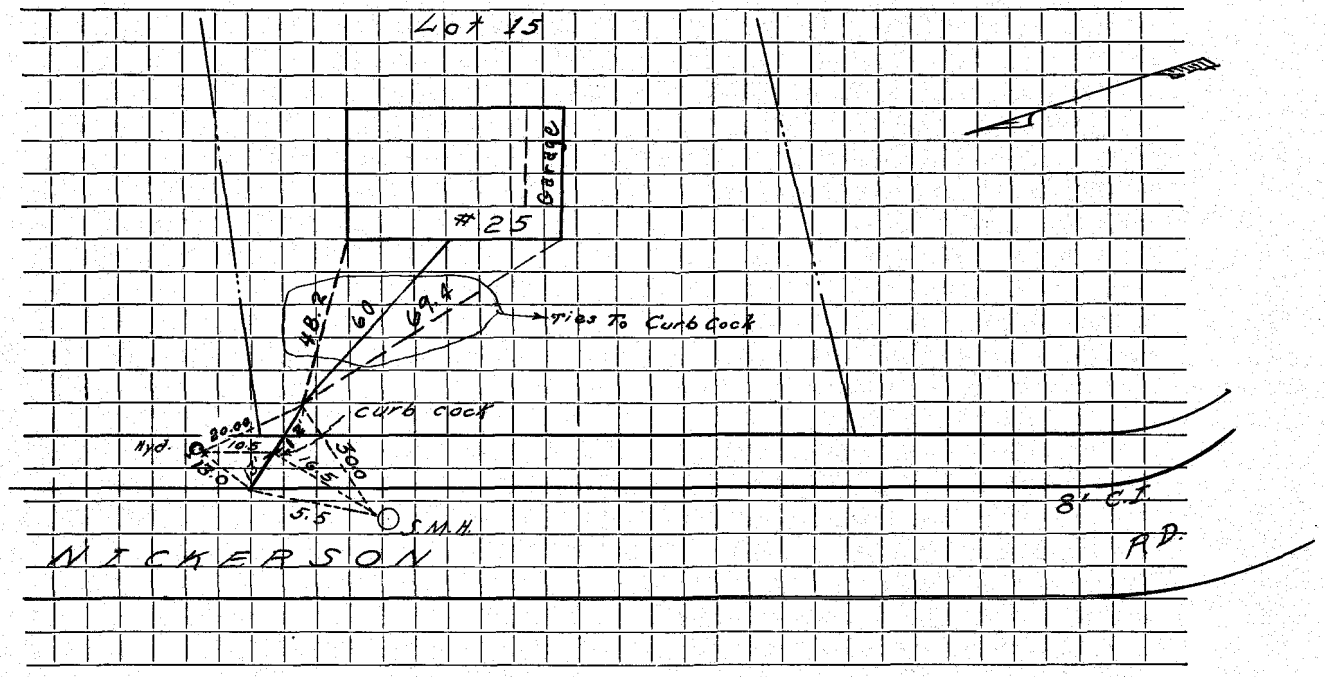

Connection made in ..... Street. Work completed .....

Remarks: .....

.....

.....