WATER SERVICE RECORD

Name Dr. Bruce Hauptman **Service No.**

Address 19A Oakland Street

Location

~~Repair~~—Renewal—~~New Service~~ Jim Redmond #4056

Date		Material	Amount	Total	Date			Amount
5/4/82	134'	1" Copper tubing						
	2	1" Unions						
		1" Stop & Waste						
							OUTSIDE	
					5/4/82	16'	1" Copper tubing	
							1" Corporation	
							1" Curb	
							Box & Rod	

DATE _____

TOWN OF LEXINGTON — BOARD OF PUBLIC WORKS

WATER DIVISION

Sketch of Service Here

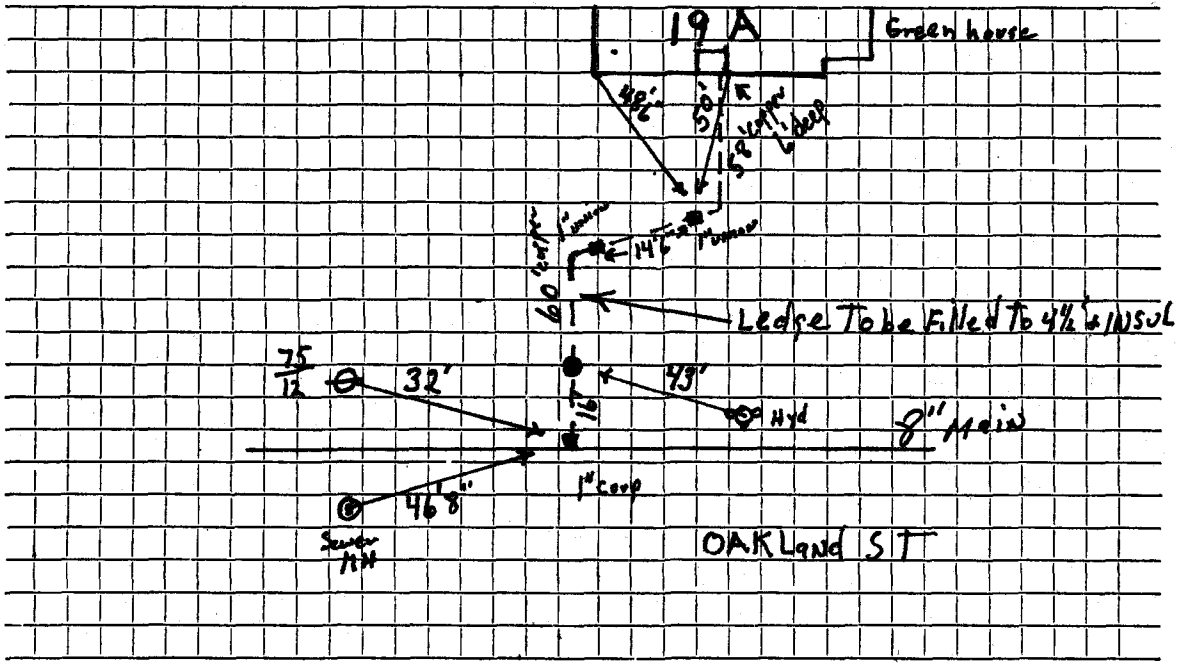

Connection made in ..... Street. Work completed .....

Remarks: Service for 19A [redacted]

.....

.....