WATER SERVICE RECORD

Name Michael D'Auria **Service No.**

Address 2 ORCHARD LANE

Location

Repair—Renewal—New Service Redmond #0129

Date		Material	Amount		Total		Date			Amount	
6-27-	91	61 LF 1" COPPER									
		1" UNION									
							5-17-	88			
									1" Copper		
									1" Curb Cock		

DATE _____

TOWN OF LEXINGTON — BOARD OF PUBLIC WORKS

WATER DIVISION

Sketch of Service Here

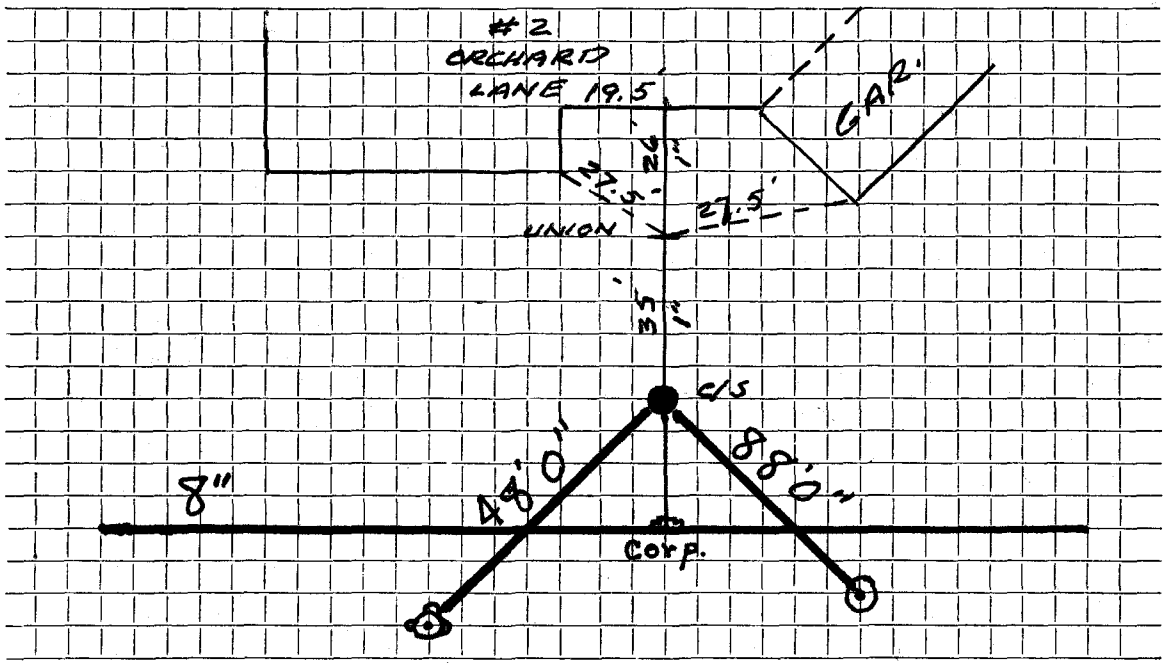

Connection made in ORCHARD LANE Street. Work completed .....

Remarks: .....

.....

.....