WATER SERVICE RECORD

Name **Service No.**

Address 49 OUTLOOK DR

Location

Repair—Renewal—New Service

Date		Material	Amount		Total		Date			Amount	
10/19/33	33'	3/4 Copper					OCT.02	16'	1" COPPER		
		3/4 x 1/2 S&W							1" Corp		
									1" Curb		
									1" x 3/4 Red		
									Buffalo box		

DATE _____

TOWN OF LEXINGTON — BOARD OF PUBLIC WORKS

WATER DIVISION

Sketch of Service Here

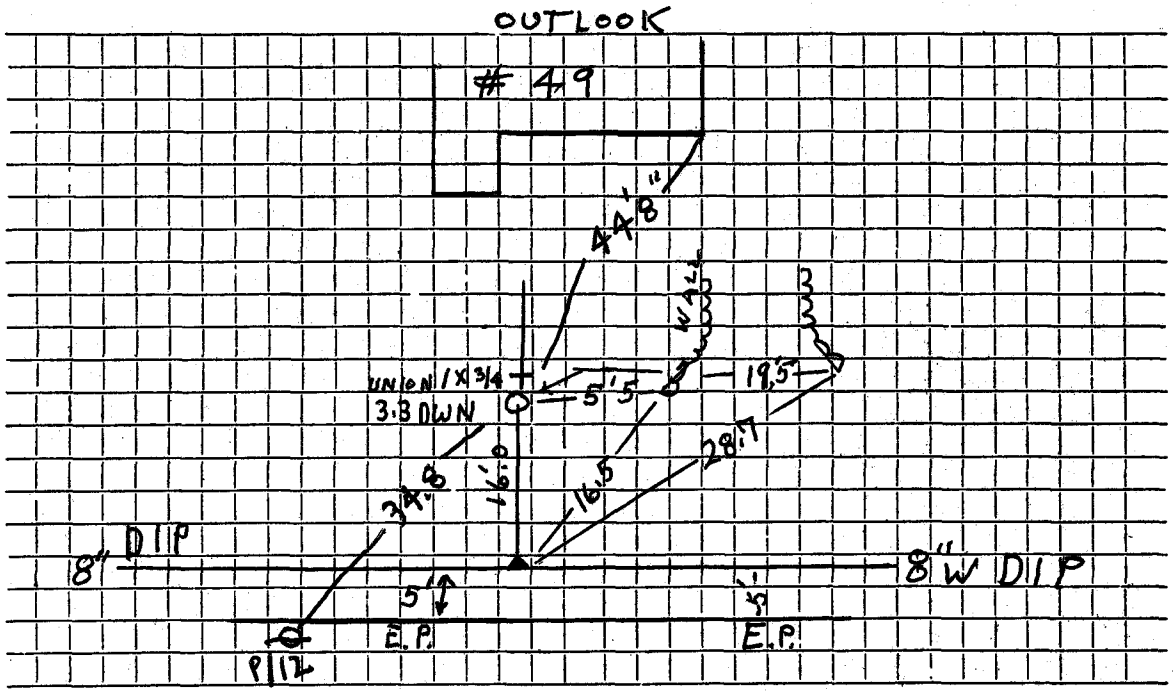

Connection made in ..... Street. Work completed SEP. 2002

Remarks: curb box IN ST. PAVed over 1.6" off Berm