WATER SERVICE RECORD

Name | **Service No.**

Address 78 Outlook Dr

Location | Permit #1393

Repair—Renewal—New Service

Date		Material	Amount		Total		Date			Amount	
		Inside							Outside		
4/28/00		↓					5/12/51				
	115'	1" Copper						20'	3/4" Copper		
	1	1" 3pt Union						1	3/4" Curb		
	1	1" Increaser						1	3/4" Corp		

DATE 4/28/00

TOWN OF LEXINGTON — BOARD OF PUBLIC WORKS

WATER DIVISION

Sketch of Service Here

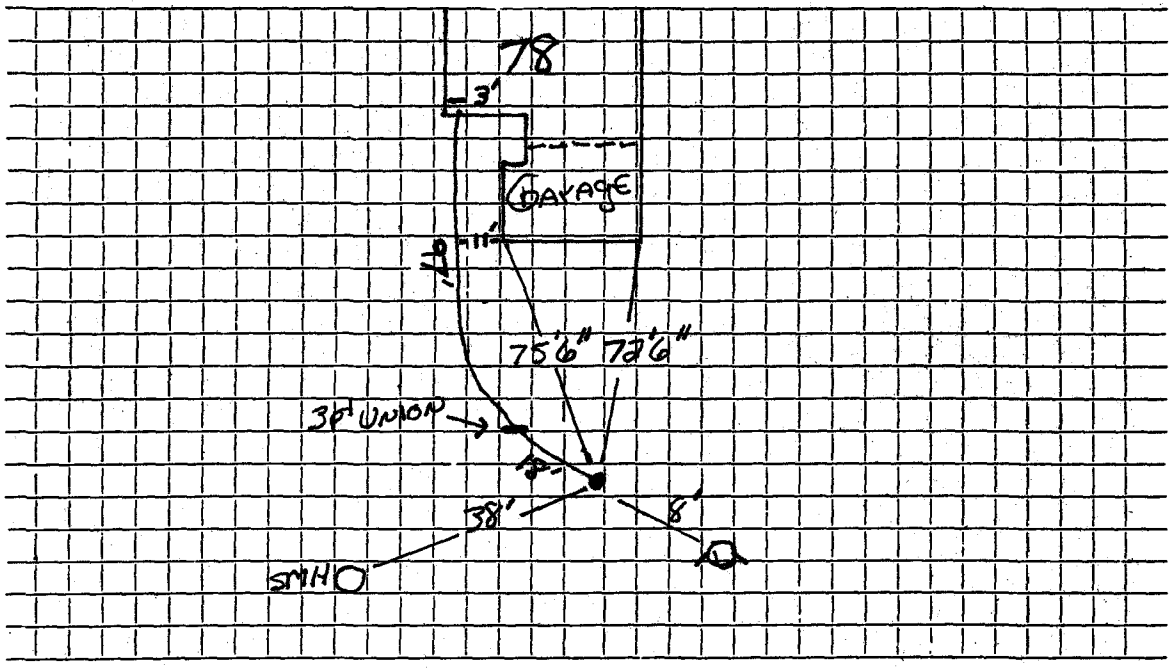

Connection made in ..... Street. Work completed .....

Remarks: .....

.....

.....