H.B.M.16010

#4870

WATER SERVICE RECORD

Name **Service No.**

Address 4 Paddock Lane

Location Lot #2

Repair—Renewal—New Service David Eagle #1060

Date		Material	Amount		Total		Date			Amount	
8-27-67	25'	3/4" Copper tubing									
3/8/68	40'	3/4" Copper Tubing									

DATE _____

TOWN OF LEXINGTON — BOARD OF PUBLIC WORKS

WATER DIVISION

Sketch of Service Here

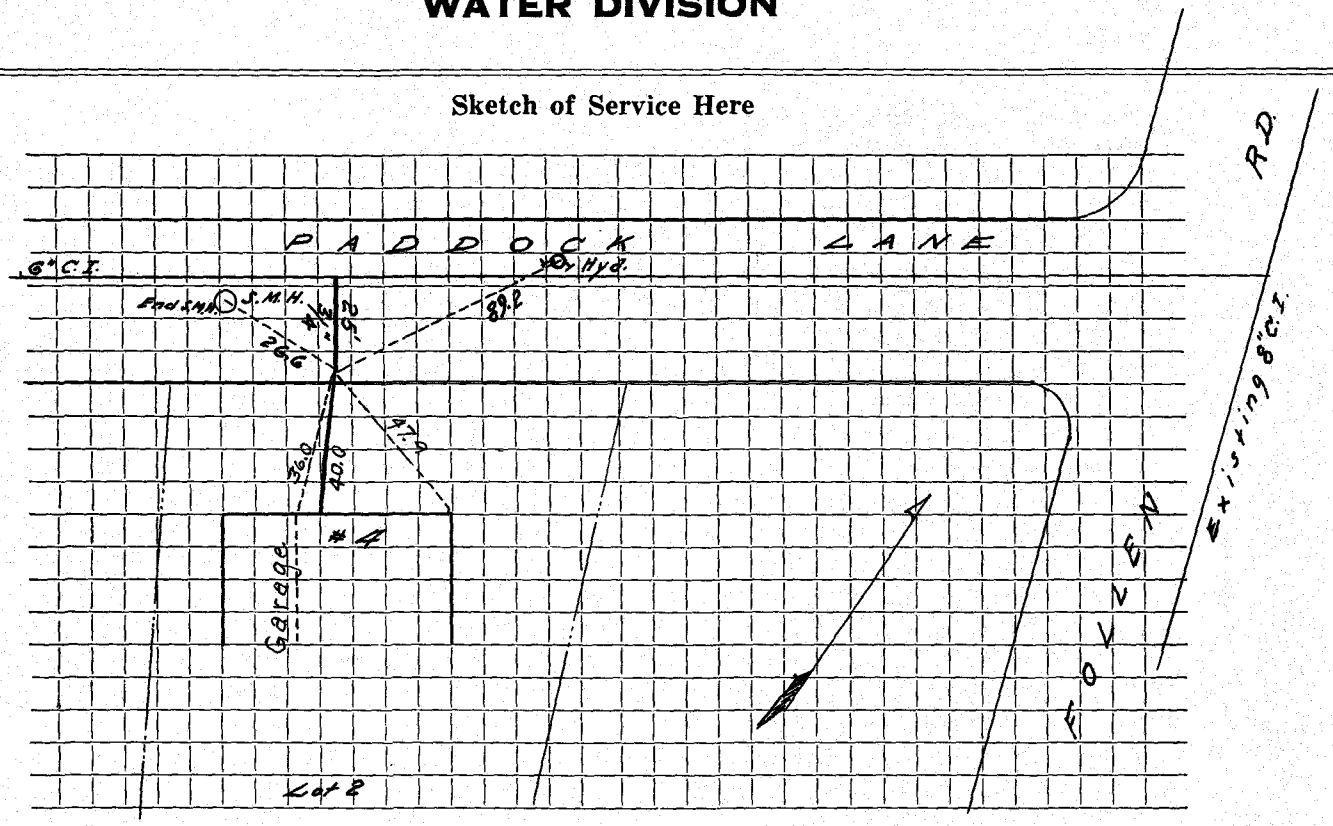

Connection made in ..... Street. Work completed .....

Remarks: .....

.....

.....