WATER SERVICE RECORD

Name **Service No.**

Address

Location 26B PARKER ST

Repair—Renewal—New Service

Date		Material	Amount		Total		Date			Amount	
							4/8/97		14' 1" COPPER		
								1	1" CORP		
								1	1" CURB		
								1	Buffalo Box		

DATE _____

TOWN OF LEXINGTON — BOARD OF PUBLIC WORKS

WATER DIVISION

Sketch of Service Here

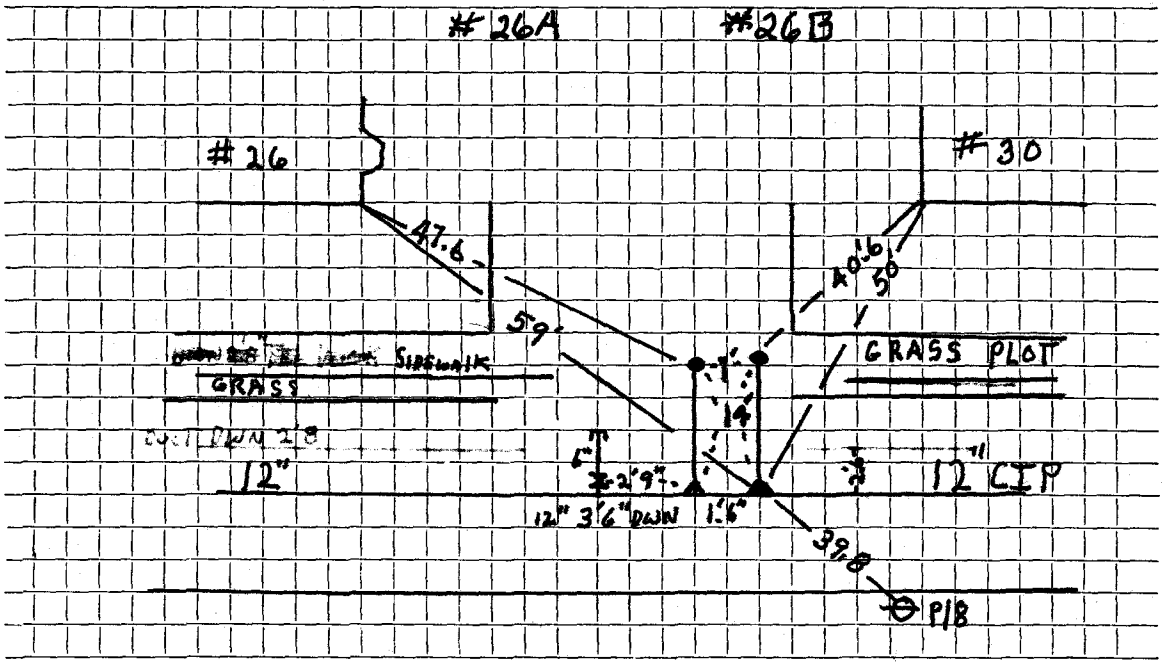

Connection made in ..... Street. Work completed .....

Remarks: 6" DIP CAPED 3' BEYOND TEL DUCT IS 2'6" WIDE .....

.....

.....