WATER SERVICE RECORD

Name Windmere Group **Service No.**

Address 4 Patriots Drive

Location Dig Safe No 974-605-871

Repair—Renewal—New Service Permit No. 1043 J.M. McLaughlin Contractor

Date		Material	Amount		Total		Date			Amount	
1-22-	98	45' 1" copper									
		1 Curb stop									

DATE 1-22-98

TOWN OF LEXINGTON — BOARD OF PUBLIC WORKS

WATER DIVISION

Sketch of Service Here

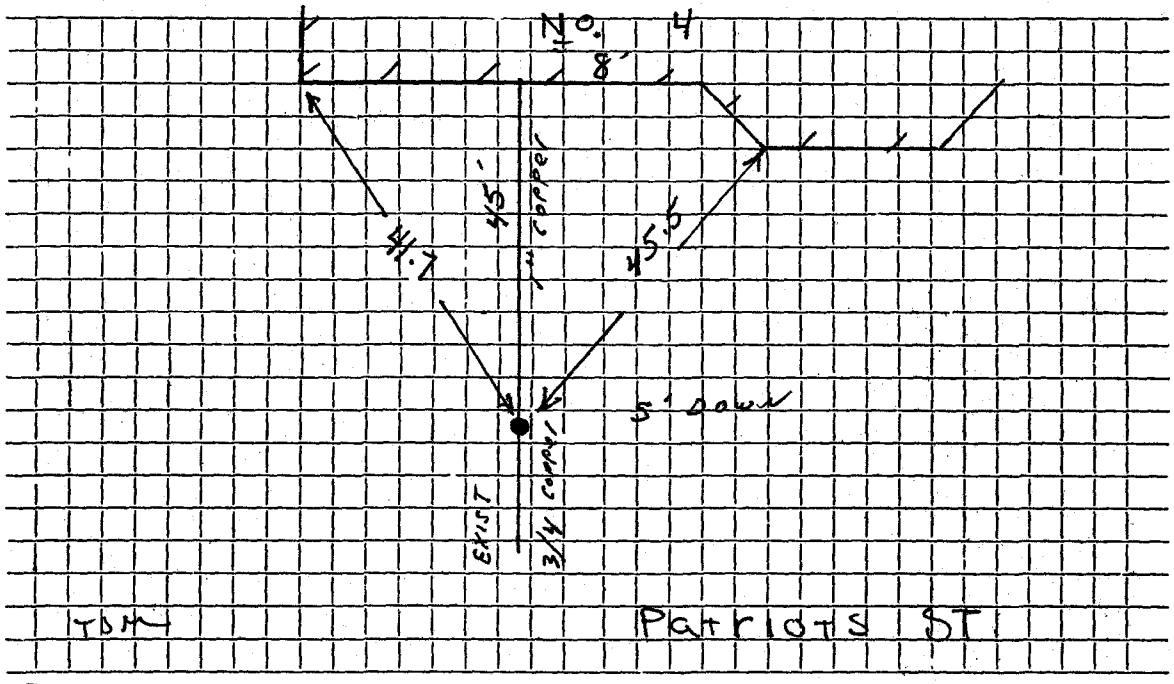

Connection made in Patriots Street. Work completed .....

Remarks: .....