# WATER SERVICE RECORD

**Name** **Service No.**

**Address** 42 PAUL REVERE RD

**Location**

**Repair—Renewal—New Service**

| Date | | Material | Amount | | Total | | Date | | | Amount | |
|---|---|---|---|---|---|---|---|---|---|---|---|
| 3/19/99 | 45' | 1" COPPER | | | | | AUG 22 | 1950 | OUT | | |
| | 1' | 3/4 COPPER | | | | | | 19' | 3/4 COPPER | | |
| | 1 | 3/4 X 1" Comp UNION | | | | | | 1 | 3/4 CORP | | |
| | | Buffalo Box | | | | | 3/19/99 → | 1 | 3/4 CURB COMP | | |
| | | INSULATION ON PIPE | | | | | | | | | |

DATE _____

TOWN OF LEXINGTON — BOARD OF PUBLIC WORKS

# WATER DIVISION

Sketch of Service Here

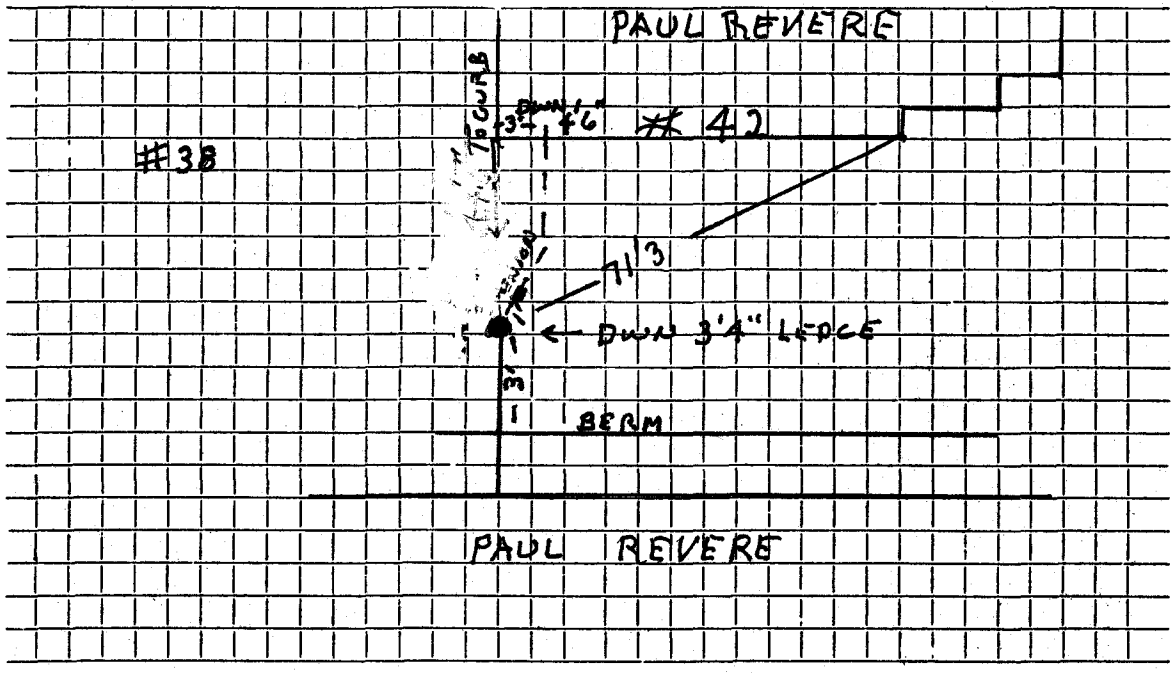


Connection made in ..... Street. Work completed .....

Remarks: 10/11/98 TEARDOWN (INSULATION ON PIPE) .....

.....

.....