H.B.M.16010

WATER SERVICE RECORD

Name J. Frank Busa **Service No.**

Address 3 Pheasant Lane

Location Lot #13

Repair—Renewal—New Service Lucente #777 Dave Eagle #2116

Date		Material	Amount		Total		Date			Amount	
5/24/68	39'	3/4" Copper tubing									
8/11/72	60'	3/4" Copper									

DATE _____

TOWN OF LEXINGTON — BOARD OF PUBLIC WORKS

WATER DIVISION

Sketch of Service Here

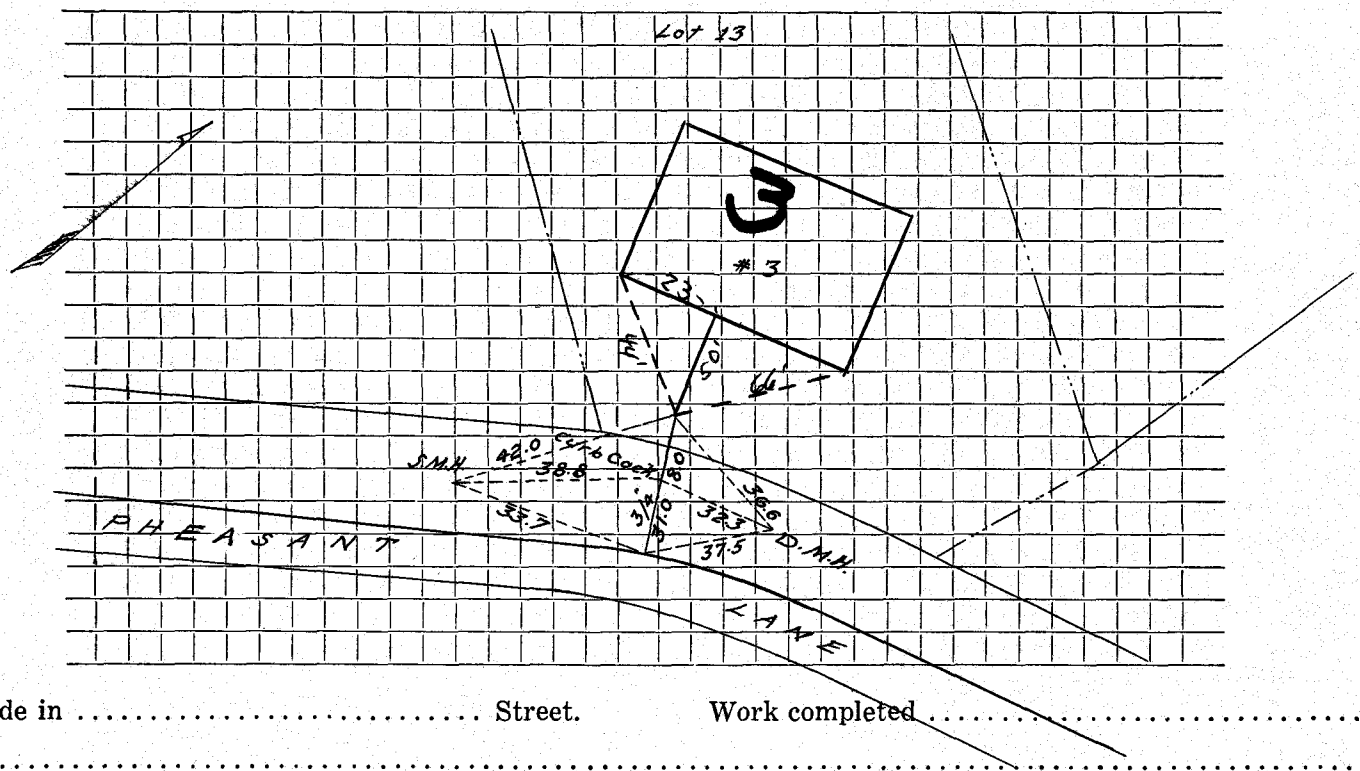

Connection made in ..... Street. Work completed .....

Remarks: .....

.....

.....